

DK 08-11

O. W. D. D.

Rice


KANSAS

Section 25 Township 18 Range 8W

Well No. #12 S. Ainsworth

Company Continental Oil et al

NORTH

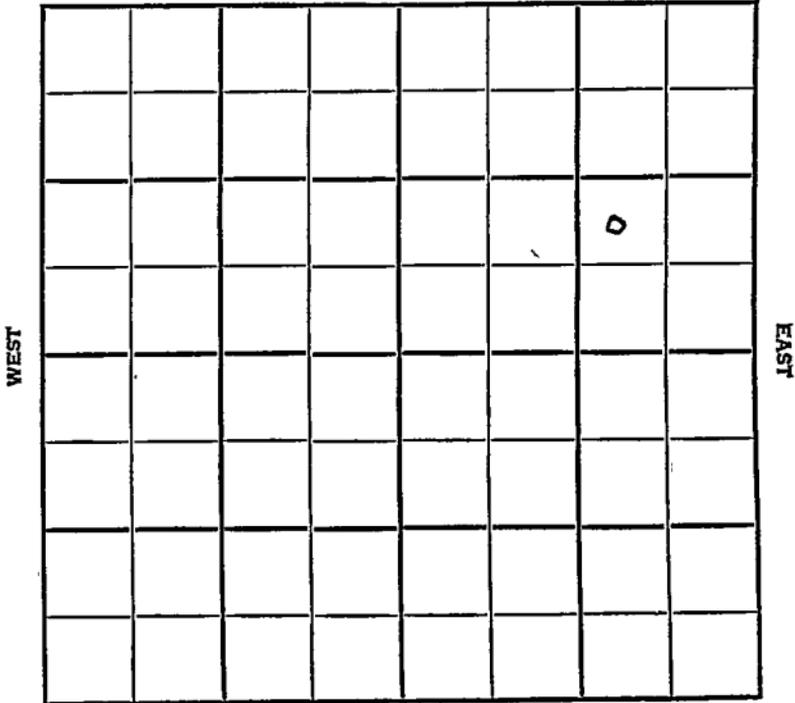

SOUTH

Rice KANSAS

|      |      |    |
|------|------|----|
| SEC. | TWP. | R. |
| 25   | 18   | 8W |

WELL NO. 12 S. Ainsworth FARM

COMPANY Continental Oil et al

CONTRACTOR


Geneseo Pool

1650 Ft. from N. Line

Ft. from S. Line

990 Ft. from E. Line

Ft. from W. Line

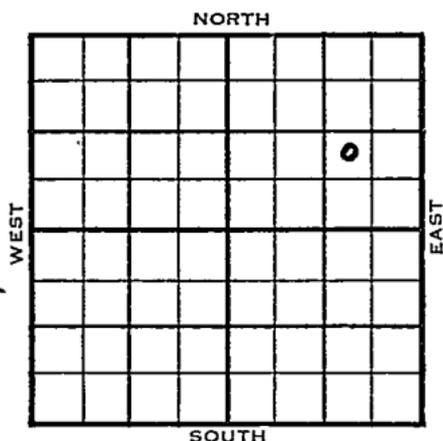

NW SE NE

|      |                    |        |
|------|--------------------|--------|
| 1954 | ELEVATION<br>1727' | REPORT |
|------|--------------------|--------|

10/6 Spud 10-1-54  
8" @ 299'

11/3 Spud 10-1-54  
Oil Well  
TD 3149'  
8" @ 299'  
Heeb 2605', Br. Lime 2735'  
Lans 2765', Cong 3105', Arb 3137'  
TD 3149'  
5" @ 3142'  
CO to 3149' S/ 3 bo 4 hr. 750 A  
S/ 32 bo 16 hr.  
Comp 50 bopd.

COMPLETED



County Rice State Kansas

Sec. 25 (Blk.) 18 (Sur.) 8W Map No.

Operator Continental etal.

Well No. 12 Farm S. Ainsworth

Elev. 1727 Location NW SE NE

|  |  |  |  |  |  |  |  |
|--|--|--|--|--|--|--|--|
|  |  |  |  |  |  |  |  |
|  |  |  |  |  |  |  |  |
1650 Ft. From N Line NE

990 Ft. From E Line Quarter

Ist. Report

Completion NOV 3 1954

Remarks Geneseo Pool

Spudding Date 10-1-54

Drlg. Data Oil well TD 3149

8" @ 299 Heeb. 2605 Br. lime 2735

Lans. 2765 Cong. 3105 Arb. 3137

TD 3149 5" @ 3142 CO to 3149

S/ 3 bo 4 hr. 750 A S/ 32 bo 16 hr.

Comp. 50 bopd

FABEN GILSTRAP

W.D.F.

✓

COMPLETE

CO. Rice ELEV. 723DF

SEC. 25 TWP. 18 RGE. 8W

COMPANY Continental Oil NO. 12

FIRST REPORT

JAN 8 '58

FARM Sam Ainsworth

(O.W.D.D.)

LOC. NW SE NE

Heeb 2605  
Br Im 2735  
Lans 2765  
Cong 3105  
Arb 3137

GEOL. \_\_\_\_\_

CONTR. \_\_\_\_\_

POOL Geneseo

SPUD \_\_\_\_\_

OLD INFO: 5" @ 3142,  
Tops.

NEW INFO: MICT & CO to  
3149, DD 3169TD Swb 2  
BOPH + 2 BWP 10 hrs, P  
30 BO + 70 BW 24 hrs, P

20 BO + 61 BW 24 hrs. from Arb open hole  
3142-69. COMPLETE

CO.

LSE.

NO.

SEC.

TWP.

RGE.