

Rice

DX 78-1


KANSAS

Section 25 Township 18 Range 8W

Well No. #13 J.R. Lansing

Company Continental et al

NORTH

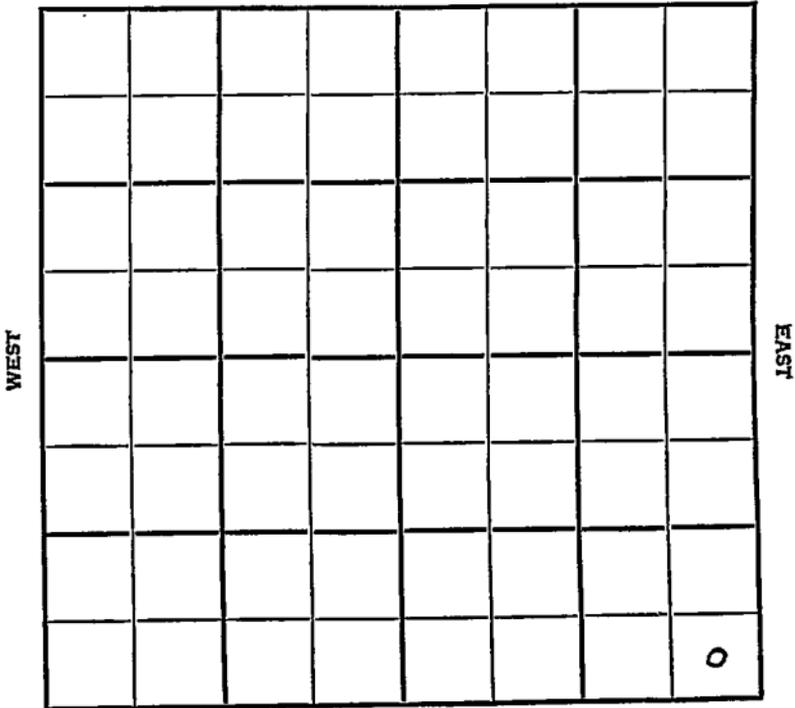

SOUTH

Rice

ANSAS

SEC.	TWP.	R.
25	18	8W

WELL NO. #13 J.R. Lansing FARM

COMPANY Continental Oil et al

CONTRACTOR G.M.R. Tools.

Geneseo Pool


NORTH

_____ Ft. from N. Line

330 _____ Ft. from S. Line

330 _____ Ft. from E. Line

_____ Ft. from W. Line

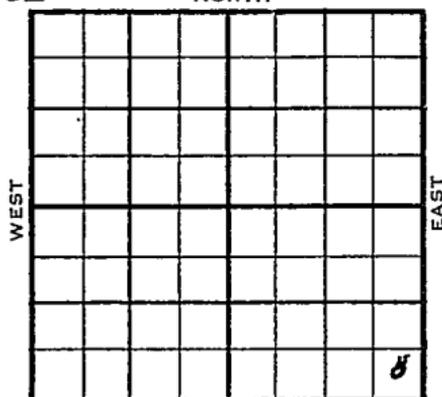

SE SE SE

SOUTH

1954	ELEVATION 1737'	REPORT
------	--------------------	--------

Arb Test.

9/29 Spud 9-27-54
8" @ 310' w/175 sks
WOC

11/23 Spud 9-27-54
Oil Well
TD 3262'
8" @ 310'
Heeb 2652' Br. Lime 2781' Lans 2813'
Cong 3161', Simp 3167' Arb. 3240'
DST 3233'-36' opn 1 hr rec 15' Mud Off
TD 3262'
5" @ 3261'
Schlumberger Tops: Heeb 2650', Lans 2811', Simp 3168' Arb 3238'
CO to 3220 63/ 3169-90
B/ 1/2 bo 1/2 bw 3 hr. sd-oil-frac.
S/ 72 bo 12hr.
Comp 79 bopd.

COMPLETED

