


KANSAS

Trego County

Section 4 Township 12 Range 22W

Well No. #1 Roberts

Company Texas

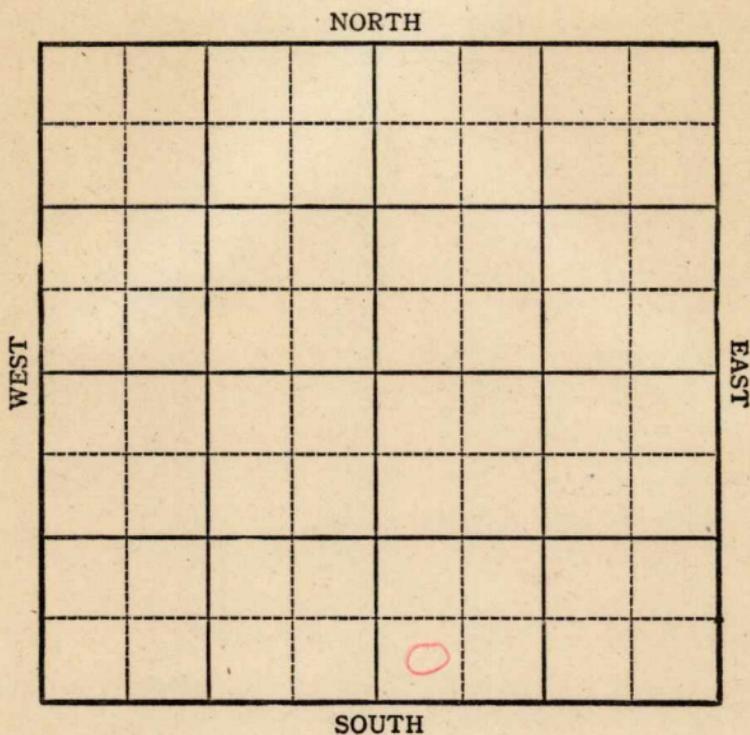

**KANSAS Special**  
Trego County

Sec. 4 Twp. 12 R. 22W

Well No. #1 Roberts Farm \_\_\_\_\_

Texas Company \_\_\_\_\_



Wildcat

\_\_\_\_\_ Ft. from N. Line

330 Ft. from S. Line

\_\_\_\_\_ Ft. from E. Line

330 Ft. from W. Line

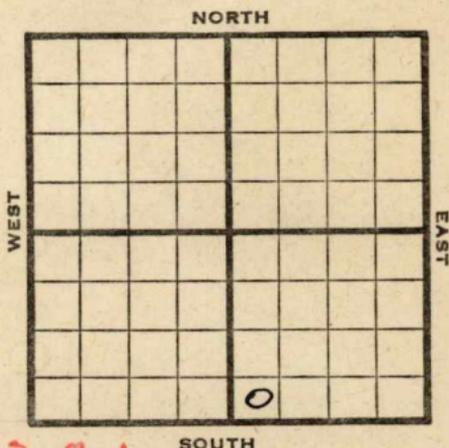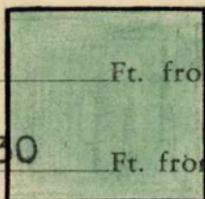

SW SE

*Elev. 2381*

R E P O R T

1944

10/18 Location

10/25 RUR

11-1 10" @ 238  
Drilling 2510'

11-8 Drilling 3895'

11/15 **Lans 3650**  
**Arb 4089**  
TD 4200'  
No shows

**ABANDONED**

**KANSAS**

Pool Name Wildcat

Map No. 69 Sec. 4 Twp. 12 R. 22W

Well No. 1 Roberts

Texas Company

FIRST REPORT Contractor

SW SE

**SECTION PLAT**

           Ft. from N. Line

330 Ft. from S. Line

           Ft. from E. Line

330 Ft. from W. Line


Trego

Location X

Rig up           

Drilling and Remarks:

*Hot File*

**RECORD**

Cased            in.,            ft.

Sand           

Gas           

Oil           

Total Depth           

**PRODUCTION**

1st 24 hrs. Nat.           

1st 24 hrs. after shot           

Gas            Cu. Ft.

Dry Hole           

Abandoned           

Date

OCT 1 8 1944 19

S. J. LEWIS Scout

