


Section 26 Township 18 Range 8 W

Well No. # 1 Anastasio

Company Bennett & Roberts

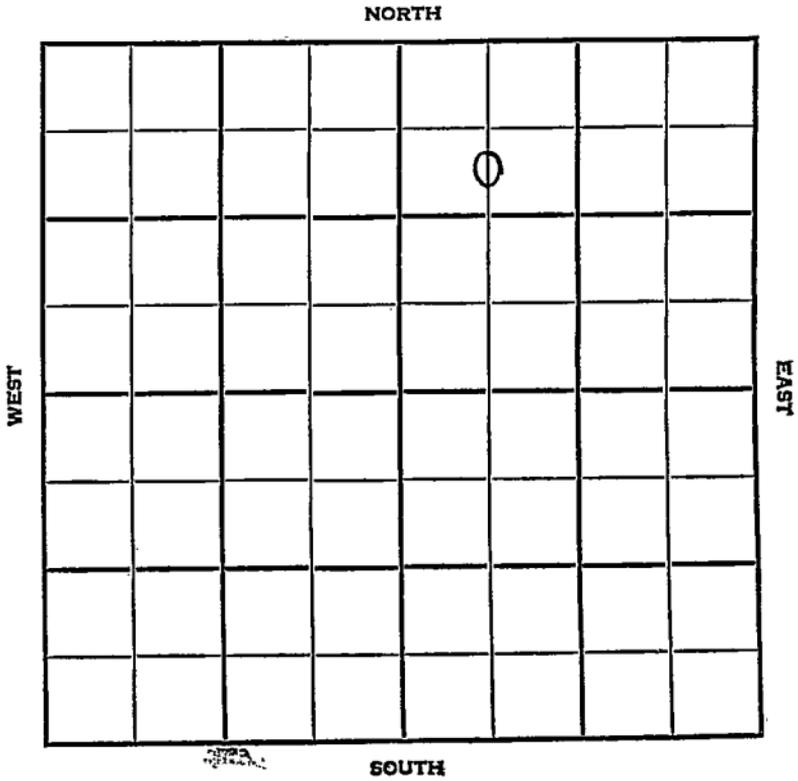

Rice

KANSAS

SEC. 26	TWP. 18	R. 8W
------------	------------	----------


WELL NO. #1 Anastasio FARM

COMPANY Bennett & Roberts

CONTRACTOR

Co. Tools. Geneseo-Edwards Pool

990 Ft. from N. Line
 _____ Ft. from S. Line
 _____ Ft. from E. Line
 660 Ft. from W. Line

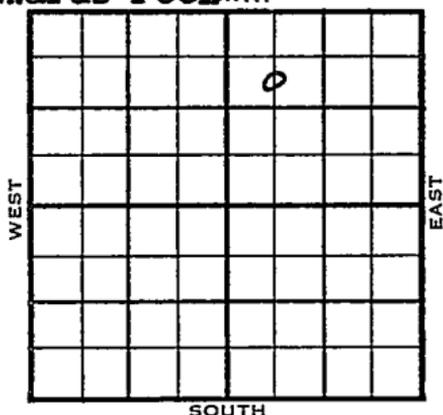

C S $\frac{1}{2}$ NW NE

1954	ELEVATION 1756'	REPORT
------	--------------------	--------

12/1 M I R
 12/15 Spud 11-30-54
 D & A
 TD 3566'
 8" @ 325'
 Heeb 2748' Br. Lime 2872' Lans 2908'
 Arb. 3546'
 TD 3566'
 D & A

ABANDONED

