


Section 26 Township 18 Range 8W

Well No. # 1 Godshalk

Company Harms & Knight et al

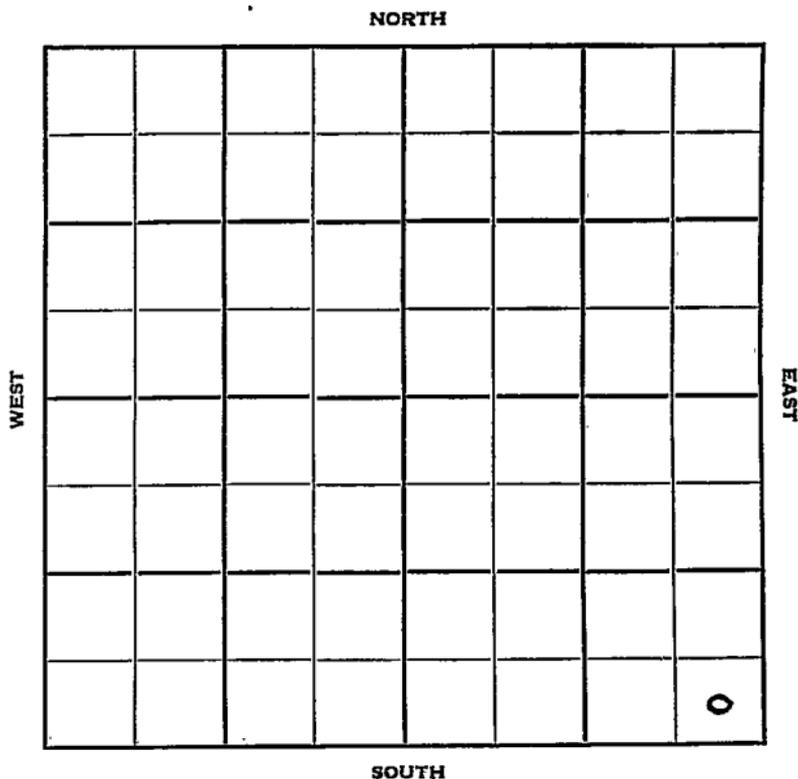

Rice

KANSAS

Sec. 26 Twp. 18 R. 8 W ✓

Well No. # 1 Godshalk Farm

Harms & Knight et al Company

Harms & Knight Contractor

Geneseo Pool


_____ Ft. from N. Line

330 Ft. from S. Line

330 Ft. from E. Line

_____ Ft. from W. Line

SE SE SE

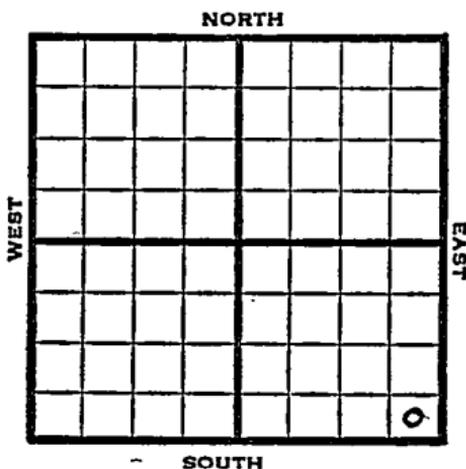

1951

Elev. 1754' REPORT

2/28

R U R

3/14

Spud 3-1-51
 D&A TD 3350
 8" @211
 Anhy 335' Heeb. 2709
 Br Lime 2833 Lans. 2866
 DST 2879-88 opn 15 min.
 Rec. 5' sgcm Cong. 3224
 Arb. 3342 TD 3350
 D&A **ABANDONED**


County Rice State Kansas

Sec. 26 (Blk. Twp.) 18 (Sur. Rge.) 8W Map No.

Operator Harms & Knight etal.

Well No. 1 Farm Godshalk

Elev. 1754 Location SE SE SE

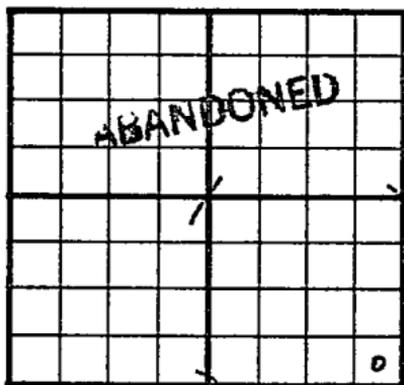

330 Ft. From S Line SE

330 Ft. From E Line Quarter

Ist. Report

Completion MAR 14 1951

Remarks Geneseo Pool

Harms & Knight - Contr.

Spudding Date 3-1-51

Drlg. Data D & A TD 3350

8" @ 211 Anhy 335 Heeb. 2709

Br. lime 2833 Lans. 2866 DST. 2879-88

open 15 min. Rec. 5⁺ sgcm Cong. 3224

Arb. 3342 TD 3350

D & A

J. E. TYRA