


Trego

KANSAS

SECTION 7 TOWNSHIP 12S RANGE 22W

WELL NO. #1 Babb "A"

COMPANY Transit Corp.

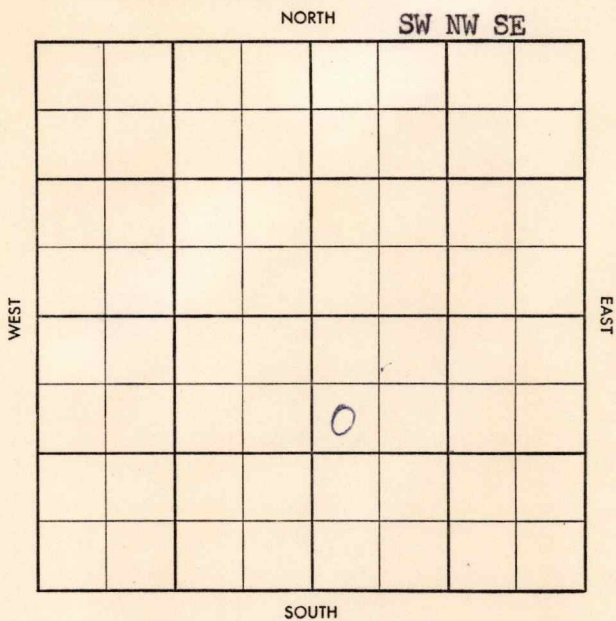

~~NO~~  
~~WILDCAT~~

S-513-B

County Trego Elev. \_\_\_\_\_  
 Sec. 7 Twp. 12S Rge. 22W  
 Company Transit Corp.  
 Farm Name Babb "A" No. 1

TOPS	DEPTH	LOG	DATUM
Anh.			
Tp.			
H.			
Tr.			
Dg.			
B.L.			
L.			
K.C.			
B.K.C.			
Ce.			
C.			
M.			
M.			
K.			
Mz.			
Mq.			
V.			
S.			
S.			
A.			
R.			
Pf.			
G.			
T.D.			

Loc. in Sec. \_\_\_\_\_  
SW NW SE  
DS - N $\frac{1}{2}$ SE $\frac{1}{4}$   
 Geol. \_\_\_\_\_  
 Contr. Co.  
 Pool \_\_\_\_\_  
Wildcat



Date Comm. 8-11-58 - Pan American FO  
8" 194; WOC

Co.  
Lse.  
No.  
Sec.  
T.  
R.

Twp \_\_\_\_\_ Pool \_\_\_\_\_

Ce. \_\_\_\_\_ Facet \_\_\_\_\_

5-513.B

County Trego Elev. 23720F 2375RB  
 Sec. 7 Twp. 12S Rge. 22W  
 Company Transit Corp.  
 Farm Name Babb "A" No. 1

TOPS	DEPTH	LOG	DATUM
Anh.			
Tp.			
H.	<u>3612</u>	<u>3614</u>	
Tr.	<u>3636</u>	<u>3638</u>	
Dg.			
B.L.			
L.	<u>3651</u>	<u>3650</u>	
K.C.			
B.K.C.		<u>3898</u>	
Ce.			
C.			
M.			
M.			
K.			
Mz.			
Mq.			
V.			
S.			
S.			
A.			
R.			
Pf.			
G.			
T.D.	<u>3925</u>		

Loc. in Sec. \_\_\_\_\_  
 SW NW SE  
DS - N $\frac{1}{2}$ SE $\frac{1}{4}$   
 Geol. \_\_\_\_\_  
 Contr. Co.  
 Pool \_\_\_\_\_  
Wildcat

**ABANDONED**  
A  
 AUG 27 '58

Date Comm. 8-11-58 - Pan American FO

8" 194; WOC AUG 20 '58 DST 3696 - 3720  
1hr 10' M FP 20 - 45 BHP 623-360  
DST 3718 - 90 2hrs 135' MSW  
FP 25-95 BHP 970 - 738 / 20"  $\phi$   
3800 AUG 27 '58 RTD 3925 Ram log  
D+A