


Trego

KANSAS

SECTION 19 TOWNSHIP 12S RANGE 22W

WELL NO. #1 Hubalek

COMPANY Imperial Oil

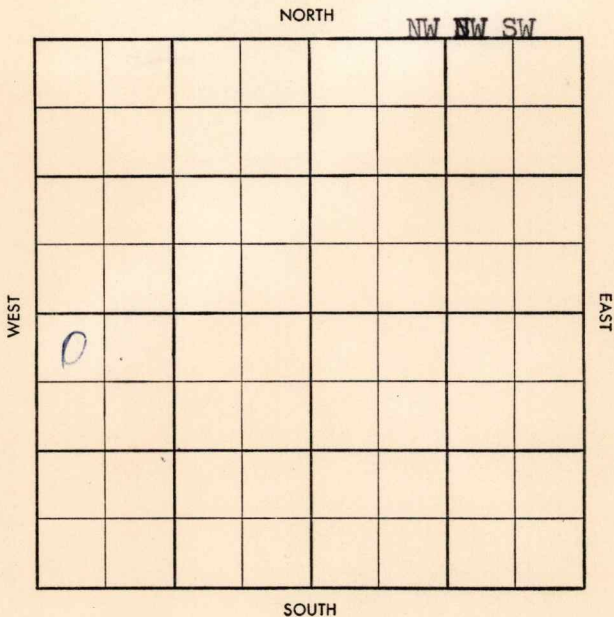

~~5~~

CO. Trego ELEV. 2412
 SEC. 19 TWP. 12 RGE. 22W
 COMPANY Imperial Oil NO. 1

FIRST REPORT	
OCT 28 1957	

FARM Hubalek
 LOC. NW NW SW

<u>Amhy 1833</u>	

GEOL. _____
 CONTR. Co. Tools
 POOL Rhoden
 SPUD 10-15-57
8" @ 209 w/175 Drlg. 3475

CO.
LSE.
NO.
SEC.
TWP.
RGE.

CO. ~~Trego~~ ELEV. ~~2412~~ ~~DP~~

ABANDONED

SEC. ~~19~~ TWP. ~~12~~ RGE. ~~22W~~

COMPANY ~~Imperial Oil~~ NO. ~~1~~

OCT 30 '57

FARM ~~Hubalek~~

LOC. ~~NW NW SW~~

Arby 1833

H 3653

JR 3676

L 3688

Mar 4022

C 4118

A 4141

TD 4180

GEOL.

CONTR. Co. Tools

POOL Rhoden

SPUD 10-15-57

8" @ 209 w/175 Dr. 3475

DST-3684

- 3710 60" 7' M

BHP110 DST 3715

- 36 60" 10' M

BHP30 DST

3736 -55 60" 15' M BHP

480 DST 3755-68 60" 12' M

BHP0 DST 3768 -79 2 hrs 240

M & W BHP 990 DST 4013 -70 2 hrs

520' W BHP 1240 m log

D & A

CO.

LSE.

NO.

SEC.

TWP.

RGE.