

Trego

DX 78-1


KANSAS

Section 11 Township 12 Range 22W

Well No. #1 Nixon

Company Cook & Galloway

NORTH

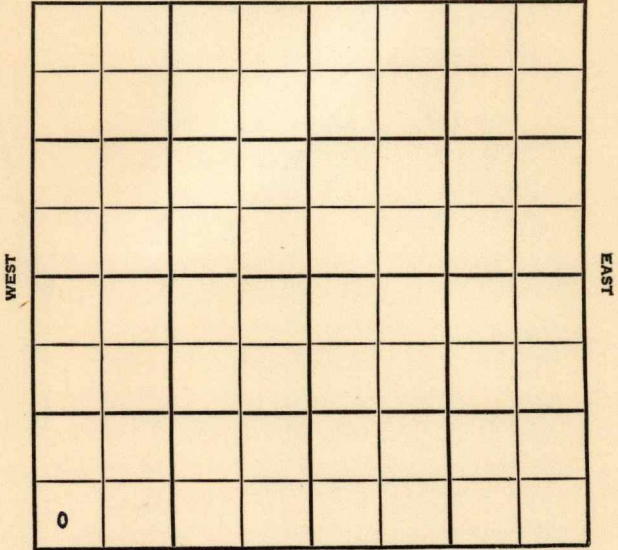

SOUTH

Trego

KANSAS


SEC.	TWP.	R.
11	12	22 W

WELL NO. # 1 Nixon FARM

COMPANY Cook & Galloway

CONTRACTOR

_____ Ft. from N. Line
 330 _____ Ft. from S. Line
 _____ Ft. from E. Line
 330 _____ Ft. from W. Line
 SW SW SW

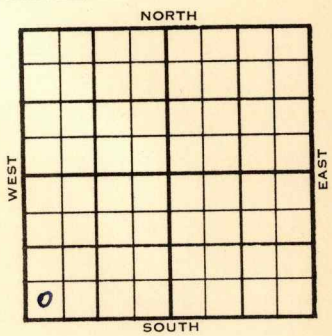

1955	ELEVATION	REPORT
	2328'	

1/19 Location
 2/9 Spud 1-25-55
 D & A
 TD 4063'
 8" @ 186'
 Anhy 1769' Top 3397' Heeb 3604'
 Tor. 3624' Lans 3638' B KC 3895'
 Cong 4021' Arb. 4036'
 TD 4063'
 D & A

ABANDONED

