


SECTION 21 TOWNSHIP 12S RANGE 22W

WELL NO. #1 Benson

COMPANY Burch Drlg.

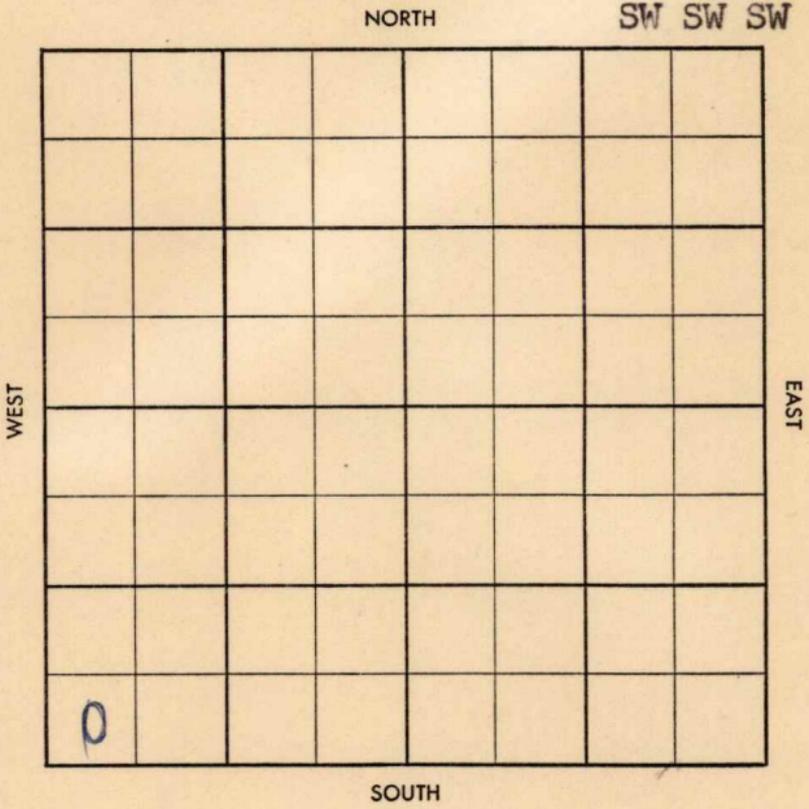

5

FORM 513 SUNRAY

County Trego Elev. _____
 Sec. 21 Twp. 12 Rge. 22W
 Company Burch Drlg.
 Farm Name Benson No. 1

Co.

TOPS	DEPTH	LOG	DATUM
Anh.			
Tp.			
H.			
Tr.			
Dg.			
Bl.			
L.			
K.C.			
B.K.C.			
Ce.			
C.			
M.			
M.			
K.			
Mz.			
Mq.			
V.			
S.			
S.			
A.			
R.			
Pe.			
G.			
T.D.			

Loc. in Sec. SW SW SW
 Geol. _____
 Contr. _____
 Co. tools _____
 Pool Ogallah

Lse.

FIRST REPORT
 SEP 11 1957

No.

Date Comm. _____
 Location Location

Sec.

T.

R.

County Trego Elev. 2375 Co.
 Sec. 21 Twp. 12 Rge. 22W
 Company Burch Drlg.
 Farm Name Benson No. 1

TOPS	DEPTH	LOG	DATUM	Loc. in Sec.
Anh.	1754			SW SW SW
Tr.				
H.	3616			
Tr.	3637			
Dg.				
BL.				
L.	3650		1275	Geol.
K.C.				Contr.
B.K.C.	3891		1516	
Ce.				Co. tools
C. <u>marm</u>	3969		1574	
M.				Pool
M.				Ogallah NW
K.				PLC
Mz.				
Ma.				
V.				
S.				
S.				
A.	4063		1678	COMPLETE DEC 18 '57
R.				
Pe.				
G.				
T.D.	4096			

Date Comm.

Location SEP 18 '57 9-11-57 8 1/2 200/150
 DST 3645-75 1hr 23' MD FPD
 Pump ahead SEP 25 '57 1sg 3829
 OCT 2, 57 DST 3710-21 1hr 15'm
 BHP 0 OCT 9 '57 DST 4064-93 60"
 15'M BHP 570 STPK DST 3714
 -29 60" 35'M 60' OCM 60' 110CM
 150' oil 120' D b w 50' oil 60'
 50CM BHP 1210 4 1/2" 3053/100
 OCT 16 '57

Co.
 No.
 Sec.
 T.
 R.

D-st 12/3724-27 PU 25 J
 Pld NT \$3B Pld Ph 75° 00' 1
 8hr A \$10 B of h 5hrs
 600 00 P 0 P OCT 23 3.13 58 NOV 6 57
 P 160 B Pld 14° 00' W 24hrs
 NOV 18 57 NOV 20 57 NOV 27 57 DEC 4 57 DEC 11 57
 DEC 18 57 PHy 73 B0 P 15° 00' W
 9v 38° Lsg 3724-27

21-12-22W

SW SW SW