


KANSAS

Section 25 Township 12 Range 22W

Well No. #1 Christian Church OGALLAH UNIT

Company Texas Co. 7-1-KGC

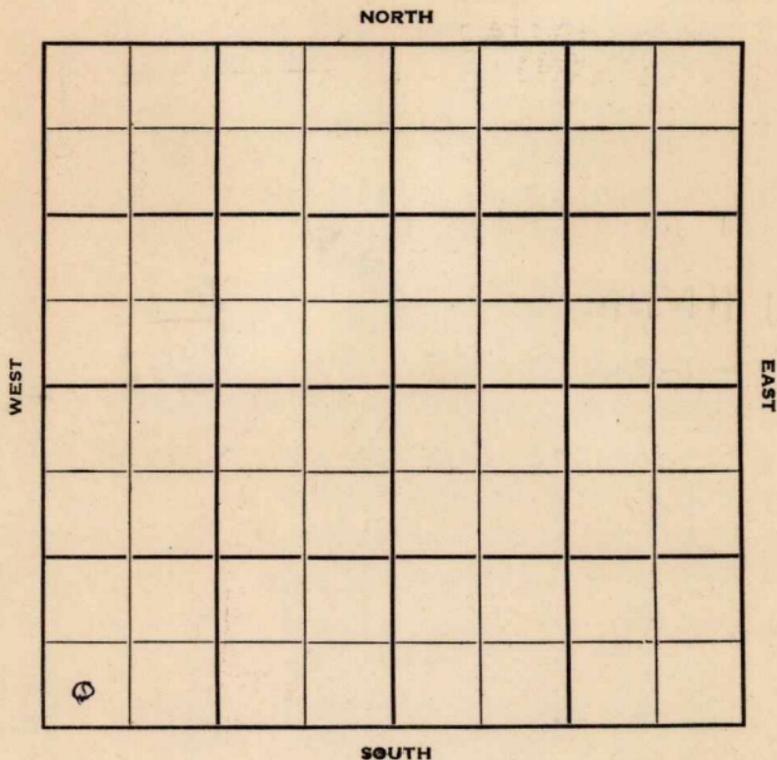

Trego

KANSAS

Sec. 25 Twp. 12 R. 22 W

Well No. # 1 Christian Church OGALLAH Farm

UNIT 7-1-1000

Texas Company Company

Contractor

Ogallah Pool


 Ft. from N. Line

330 Ft. from S. Line

 Ft. from E. Line

330 Ft. from W. Line

SW SW SW

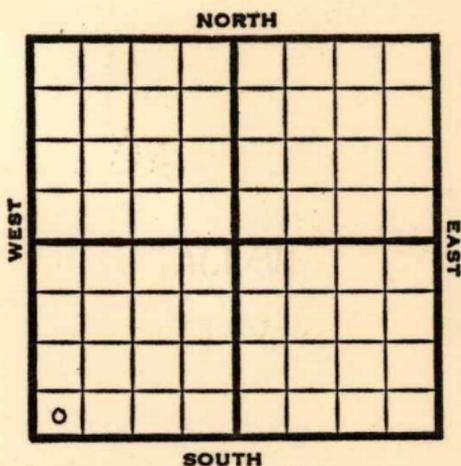

1951 **Elev. 2345'** REPORT

8/29 Location

10/24 Spud 9-9-51

Oil Well TD 4040'

8" @ 5188 **Heeb. 3575** **Lans. 3608**

Arb. 4008 TD 4040'

5" @ 4036'

36/ 4008-20 FU 600' oil $\frac{1}{2}$ hr.

S/ 40 BOPH 52/4020-34 S/ 66 BOPH

Comp. 3000 BOPD

COMPLETED

