
Rice

Form 51—5M—3-35—Mid-West

Map No. KANSAS Sec. 36 Twp. 18 R. 8W

Well No. #1-DeFoe Farm

Derby Oil Company

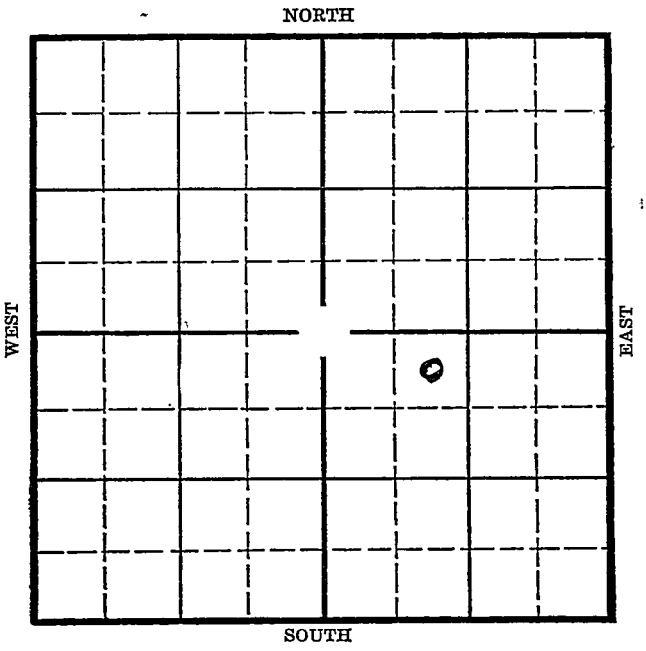

Location

Drilling Remarks

Rig Up

Drilling Remarks

RECORD

Cased in. ft.

Sand

Gas

Oil

Total Depth

PRODUCTION

1st 24 hrs. Nat.

1st 24 hrs. after shot

Gas cu. ft.

Dry Hole

Abandoned

Form 252-A
5M 7-35 MPC

RICE

Map No. KANSAS Sec. 36 Twp. 18 R. 8-W

Well No. 1-DeFoe Farm

Derby Oil Company


330 Ft. from N. Line

_____ Ft. from S. Line

_____ Ft. from E. Line

990 Ft. from W. Line

Elev. 1747

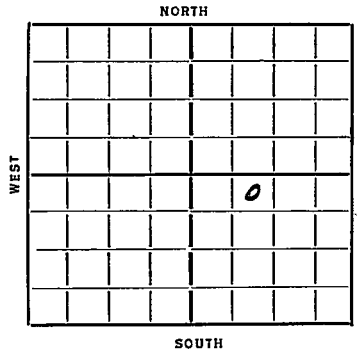

Date 1936	REPORT
4/1	Rot. Rig
4/10	Rigging up.
4/16	156' of 15". Drlg. 235'
4/23	Drlg. 1625'.
4/30	Drlg. 2775'
5/7	Sand 3301' Core 3306-11'
	3311' T.D.
5/14	7" @ 3300'. T.D. 3322'. RUST.
5/20/36	Sil. 3340'.
	HFW.
	T.D. 3342'.
	D & A
	ABANDONED

Form 26—1M Bks.—9-28

Map No. 45 Sec. 36 Twp. 18 R. 8W

Well No. 1- DeFoe

Derby Oil Company

Contractor

FIRST REPORTS


330 Ft. from N. Line

Ft. from S. Line

Ft. from E. Line

990 Ft. from W. Line

SECTION PLAT

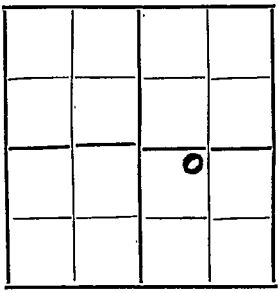

Location

Rig up

Drilling and Remarks:

Rot. Rig

RECORD

Cased in., ft.

Sand

Gas

Oil

Total Depth

PRODUCTION

1st 24 hrs. Nat.

1st 24 hrs. after shot

Gas Cu. Ft.

Dry Hole

Abandoned

Date

4-1-36 192

ORVAL MANNSCHRECK Scout

Form 26—IM Bks.—2-29

KANSAS


Map No. 45 Sec. 36 Twp. 18 R. 8 XX

Well No. 1 Dr Fee.

Derby Oil Company

Contractor

SECTION PLAT

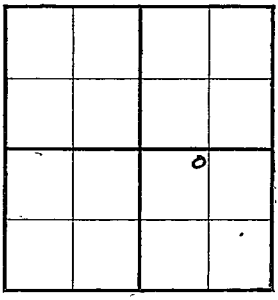

330 Ft. from N. Line

_____ Ft. from S. Line

_____ Ft. from E. Line

990 Ft. from W. Line

ABANDONED

Location _____

Rig up _____

Drilling and Remarks:

SC C3340

NFW

DH

RECORD

Cased _____ in., _____ ft.

Sand _____

Gas _____

Oil _____

Total Depth 3342

PRODUCTION

1st 24 hrs. Nat. _____

1st 24 hrs. after shot _____

Gas _____ Cu. Ft.

Dry Hole _____

Abandoned _____

Date

MAY 20 1936 19

S. J. LEWIS Scout