

State Kansas County Barton


Company Messman - Rinehart Corp. Well No. 1

Farm Byers Estate

Survey \_\_\_\_\_

Block No. \_\_\_\_\_ Sec. 33 Twp. 18S Range 13W

Co-Ord. Contr. Sterling Drlg. Elev. 1908 RB

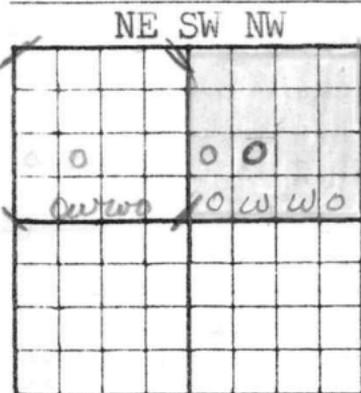

Robert E. Davis 1/3 int  
 RLM 1/3 int  
 CBR 1/3int

J. George Klein ORRI

( OWWO )

NOTE: Show Sketch of Lease and Well Location in Above Space

Ft. from N. Line

Ft. from S. Line

Ft. from W. Line

Ft. from E. Line

Date	Depth	8" Csg. @ 241 feet, 160 sx
OTD	3550'	Large Scale Elec. Log
2-19-79		Move in and RUR
2-20-79		Finish rigging up, started DOC 12:30 p.m., solid cement to 225', clean out to top of fish at 567', come out to pick up washover pipe.
2-21-79		Ran wash pipe to 685'. Down beside csg, pick up bit & run to 685'

Date	Depth	717242
6-22-79		Come out of hole & run
		electric log (Electra, Inc.)
		Determined top of fish 568'
		run bit back in. Drilling
		along side csg. to 1103'
6-23-79		Started out of hole & stuck
		drill pipe 3 jts. off bottom
		run Dia-Log free point
		& backed off drill collars
		leaving 3 drill collars in
		the hole.
		Plugged & Abandoned
		6-23-79
	1103'	T.D. (workover)