

Sec. 25 Twp. 12 R. 22W

Well No. #2 Wynn OGALLAH UNIT 2 Farm

Texas

Company

Powell

Contractor

Ft. from N. Line

330


Ft. from S. Line

Ft. from E. Line

990

Ft. from W. Line

SE SW SE

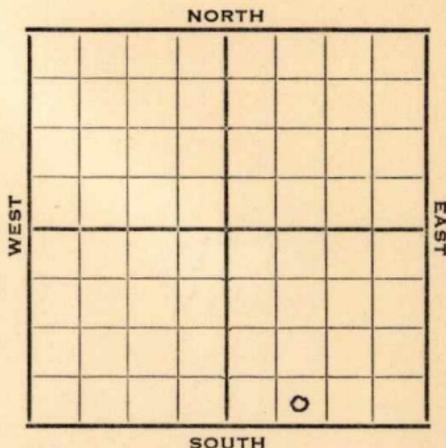

1952

Elev. 2318

REPORT

6/25

Spud 6-22-52
8" @ 492' WOC

7/2

Drlg. 3123

7/9

Topeka 3368 Heeb. 3567 Lans. 3598
BKC 3836 Simp 3959
Arb. 3977 RTD 4006

5" @ 3977 Rust DP

7/17

CO 4006 S/5 $\frac{1}{2}$ BOPH POP

7/23

Spud 6-22-52
Oil Well TD 4006
8" @ 492

Top 3368 Heeb. 3567
Lans. 3598 BKC 3836 Simp 3959
Cored 3979-4005 Rec. 26' dol.
Arb. 3977 TD 4006 5" @ 3977
CO to 4006 S/5 $\frac{1}{2}$ boph Comp. 166
bopd

