

Section 25 Township 12 Range 22W

Well No. #5 Church of Ogallah

Company Texas

NORTH

0							

SOUTH

WEST

EAST

Trego

KANSAS

Sec. 25 Twp. 12 R. 22 W ✓

Well No. # 5 Church of Ogallah Farm

~~Noble~~ Texas Co. Company

Noble
Ogallah Contractor


Ft. from N. Line

330 Ft. from S. Line

Ft. from E. Line

330 Ft. from W. Line

SW SW NW

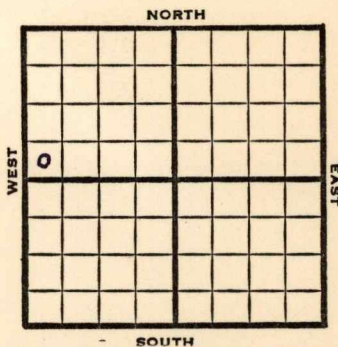

1952

Elev. 2343'

REPORT

1/9 Spud 1-6-52
8" @ 496'

2/6 Tstg.

2/13 S/4 BO & 20 BW 17 hrs. PB 4018

2/20 S/1/2 gal oil plus 5 gal WPH. 500 A
S/2-7/10 BO Plus 2-7/10 BWPH
POP

3/5 No report

3/12 Oil Well TD 4027
8" @ 496
Top. 3399 Heeb. 3595
Lans. 3626 Arb. 4013
TD 4015 5" @ 4014 4 goph
DD 4022 14 goph DD 4025
Hydro S/ 16 1/2 bo 24 bw 6 hr.
DD 4027 PB 4025 S/ 9 bo 22 bw
12 hr. S/ 4 bo 26 bw 17 hr.
PB 4018 S/ 1/2 go 5 gwph 500 A
S/ 2.7 bo 2.7 bwph
Comp. 179 bopd 160 bw

COMPLETED

County **Trego** State **Kansas**
Sec. **25** (Blk. **12** (Sur. **22W** Map No.

Operator **Texas**

Well No. **5** Farm **Church of Ogallah**

Elev. Location **SW SW NW**

FIRST REPORT

330 Ft. From **S** Line **NW**

330 Ft. From **W** Line Quarter

1st. Report **JAN 9 1952**

Completion

Remarks

Noble - Contr.

Spudding Date **1-6-52**

Drilg. Data

Ogallah

8" @ 496

J. E. TYRA

