

"Site"

State Kansas County Barton

Company Messman-Rinehart Well No. 1


Farm BYERS

Survey

Block No. Sec. 33 Twp. 18S Range 13W

Co-Ord. Elev.

NW SW NW

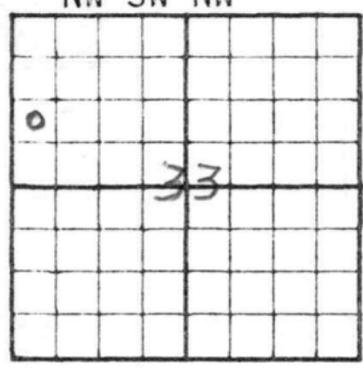

Robert E. Davis 1/3  
 R. L. Messman 1/3  
 C. B. Rinehart 1/3

NOTE: Show Sketch of Lease and Well Location in Above Space

Ft. from N. Line

Ft. from S. Line

Ft. from W. Line

Ft. from E. Line


Date	Depth	
11-20-78		Run Electra elec. log to 3100'
12-13-78		MICT. Rig up & set bridge plug @ 3140'. Perf. Toronto 3088-91' - 4 shots/ft. (Electra) Run.tbg. & start to swab fluid.
12-14-78		Finish swab hole dry. Small show oily wtr. 250 MCA.

Date	Depth	Pressure to 1200#. No gas.
		SI over nite w/1200# on well
12-15-78		Lost 50# pressure over nite.
		Pressure up again. Still no
		go. Pull tbg. & reperforate.
		Run Baker packer. Set @
		3065'. Swab dry.
12-16-78		Acid 300 gal. 15% & 1%
		detergent. Break @ 750#.
		Swabbing 1.5 bbl. wtr./hr.
		w/small rainbow oil.
12-18-78		1000' wtr. in hole. Pull tbg.
		& packer; set bridge plug
		@ 3070'. Perf. 3030-34 w/4
		shots/ft. (Electra). Set
		packer @ 3001'. Swab tbg. dry.
		300 gal. 15% acid. Finish
		flush @ 500#. Vacuum
		immediately. Hole in tbg.
12-19-78		Pull tbg. & packer & found
		hole in tbg. Rerun packer &
		tbg. Swab 2 BOPH & trace wtr.
		for 5 hrs.
12-20-78		1100' oil, 100' wtr. in hole
		Tear down cable tools.

State Kansas County Barton  
 Company Messman-Rinehart Well No. 1  
 Farm Byers  
 Survey \_\_\_\_\_  
 Block No. \_\_\_\_\_ Sec. 33 Twp. 18S Range 13W

Co-Ord. \_\_\_\_\_ Elev. \_\_\_\_\_

NW SW NW

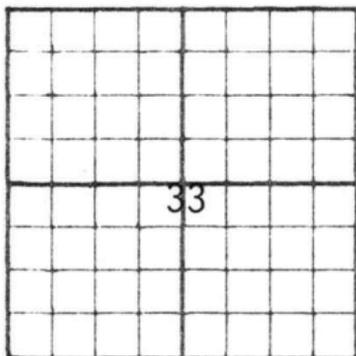

1/3 - Robt. E. Davis  
 1/3 - Roger L. Messman  
 1/3 - C. B. Rinehart

NOTE: Show Sketch of Lease and Well Location in Above Space

Ft. from N. Line

Ft. from S. Line

Ft. from W. Line

Ft. from E. Line

Date	Depth	
9/11/79		Move in Rig (Roxana Corp.)
		Rig up and pick up 5½" tools.
		Drill and drive bridging plug
		from 3070' to top of second
		bridging plug at 3140'. Drlg.
		on both plugs, Shut down.
9/12/79		Drill & drive plugs from
		3140' to T.D. (3412')
9/13/79		Bail hole and clean out to

