

12

33

2 E

Section \_\_\_\_\_ Township \_\_\_\_\_ Range \_\_\_\_\_

Well No. # 1 YeagerCompany L. B. Jackson

NORTH

16

WEST

EAST

|  |  |  |  |  |  |  |   |
|--|--|--|--|--|--|--|---|
|  |  |  |  |  |  |  |   |
|  |  |  |  |  |  |  |   |
|  |  |  |  |  |  |  | 0 |

SOUTH

Summer

KANSAS

Sec. 12 Twp. 33 R. 2E

Well No. #1 Yeager Farm

L. B. Jackson Company

Jackson Contractor

Wildcat


         Ft. from N. Line

330 Ft. from S. Line

330 Ft. from E. Line

         Ft. from W. Line

SE SE SE

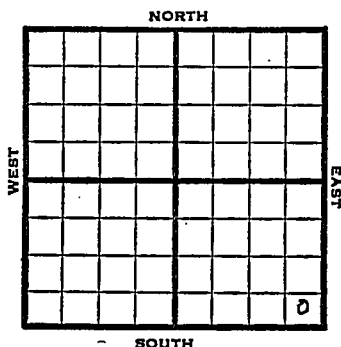

1952

Elev. 1169' REPORT

10/1

Drlg. 2000

10/15

Drlg. Date: D&A TD 3304'  
Stal. 2230', Layton 2670', KC 2816',  
Oswego 3000', Cherokee 3134, Bart  
3257', Miss 3263  
TD 3304'  
D&A

**ABANDONED**

County Sumner State KansasSec. 12 (Blk. Twp.) 33 (Sur. Rge.) 2E Map No.Operator L. B. JacksonWell No. 1 Farm YeagerElev. Location SE SE SE

|  |  |  |  |  |  |  |  |  |  |
|--|--|--|--|--|--|--|--|--|--|
|  |  |  |  |  |  |  |  |  |  |
|  |  |  |  |  |  |  |  |  |  |
330 Ft. From S Line SE330 Ft. From E Line Quarter1st. Report OCT 1 1952


Completion

Remarks

Jackson - Contr.

Spudding Date

Drlg. Data Wildcatdrlg. 2000

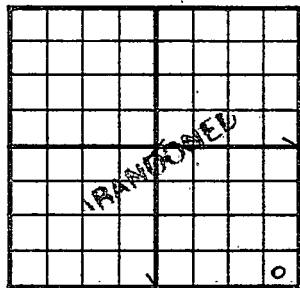County Sumner State KansasSec. 12 (Blk. Twp.) 33 (Sur. Rge.) 2E Map No.           Operator L. B. JacksonWell No. 1 Farm YeagerElev. 1169 Location SE SE SE330 Ft. From S Line SE330 Ft. From E Line Quarter1st. Report           Completion OCT 15 1955Remarks WildcatJackson Drlg. - Contr.Spudding Date           Drlg. Data D & A TD 3304Stal. 2230 Layton 2670 KC 2816Oswego 3000 Cherokee 3134 Bart. 3257Miss. 3263 TD 3304D & A

J. G. McGEHEE