

Trego

KANSAS

SECTION 26 TOWNSHIP 12 RANGE 22 W

WELL NO. #3 Edna Alice Scott OGALLAH UNIT

COMPANY Stanolind 3-3-1000

NORTH

| | | | | | | | |
|--|---|--|--|--|--|--|--|
| | | | | | | | |
| | | | | | | | |
| | | | | | | | |
| | | | | | | | |
| | | | | | | | |
| | | | | | | | |
| | | | | | | | |
| | 0 | | | | | | |

WEST

EAST

SOUTH

Trego

KANSAS

| | | |
|------------|------------|-----------|
| SEC. 26 | TWP. 12 | R. 22W |
|------------|------------|-----------|

WELL NO. #3 Edna Alice Scott **OGALLAH UNIT** **3-3** **FARM**

COMPANY Stanoline **KCC**

CONTRACTOR Transit

Ogallah


_____ Ft. from N. Line

_____ Ft. from S. Line

_____ Ft. from E. Line

_____ Ft. from W. Line

~~#~~ SE SW SW

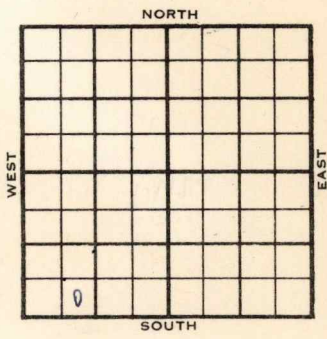

| | | |
|------|-----------|--------|
| 1955 | ELEVATION | REPORT |
|------|-----------|--------|

| | | |
|-------|----------|--|
| 12-21 | Location | |
|-------|----------|--|

County ~~Trego~~ Elev. _____
 Sec. 26 Twp. 12 Rge. 22W
 Company Stanolind OGALLAH UNIT 3-3-KCC

Co.
Lse.
No.
Sec.
T.
R.


| TOPS | DEPTH | LOG | DATUM |
|--------|-------|-----|-------|
| Anh. | | | |
| Tp. | | | |
| H. | | | |
| Tr. | | | |
| Dg. | | | |
| BL. | | | |
| L. | | | |
| K.C. | | | |
| B.K.C. | | | |
| Ce. | | | |
| C. | | | |
| M. | | | |
| M. | | | |
| K. | | | |
| Mz. | | | |
| Ma. | | | |
| V. | | | |
| S. | | | |
| S. | | | |
| A. | | | |
| R. | | | |
| Pe. | | | |
| G. | | | |
| T.D. | | | |

Loc. in Sec. _____
SE 34 SW
 Geol. _____
 Contr. _____
Transit
 Pool _____
Ogallah

| | | |
|--|--|--|
| | | |
| | | |
| | | |

FIRST REPORT
 DEC 21 1955

Date Comm. _____
 Location _____

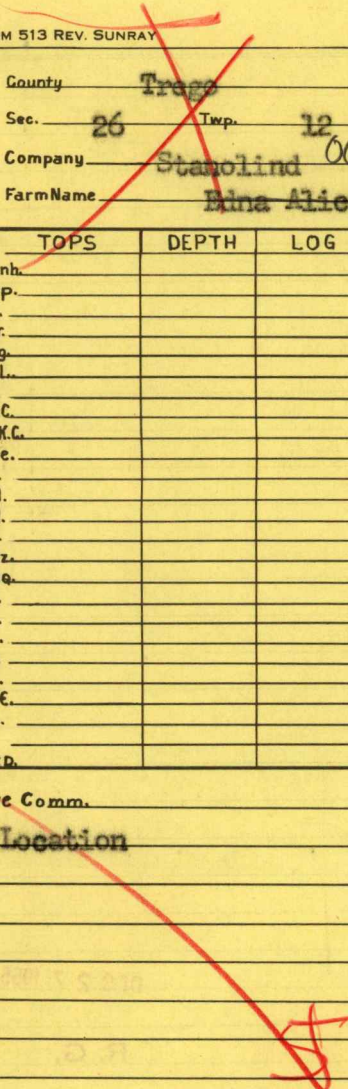

7

 Foreman Edna Alice Scott No. 3

| | TOPS | DEPTH | LOG | DATUM |
|------------------|------|-------|------|-------|
| Asht | | 1740 | | |
| Tr | | | | |
| H | | | 3564 | |
| Tc | | | 3580 | |
| Bo | | | | |
| Bl | | | | |
| L | | | 3599 | 1261 |
| Lc | | | | |
| BXC | | | 3826 | 1498 |
| Co. <u>Des M</u> | | | 3884 | 1516 |
| C. <u>Morm</u> | | | 3926 | 1588 |
| M | | | | |
| M | | | | |
| M | | | | |
| M | | | | |
| M | | | | |
| V | | | | |
| S | | | | |
| S | | | | |
| A | | | | |
| R | | | | |
| R | | | | |
| Q | | | | |
| 30 | | 4004 | | |

Loc. in Sec. SE SW SW
 Geol. _____
 Cont. Transit
 Pool Ogallah

| | | |
|--|--|--|
| | | |
| | | |
| | | |

COMPLETE

FEB 29 1956

Date Comm. _____
 Location DEC 28 '55 12-20-55 8579
202/150 @ 2050 JAN 5 '56 crd
3999-4004 see 5' Dal (satur)
5 1/2 4000/800 Log JAN 11 '56 west
JAN 18 '56 Co 4004 & 16 Baph n/w
10 hrs PUP JAN 25 '56 FEB 1 '56 FEB 8 '56
FEB 15 '56 ✓ FEB 22 '56 ✓ FEB 29 '56 Ph P 169
Baph n/w
gravel 37.2'