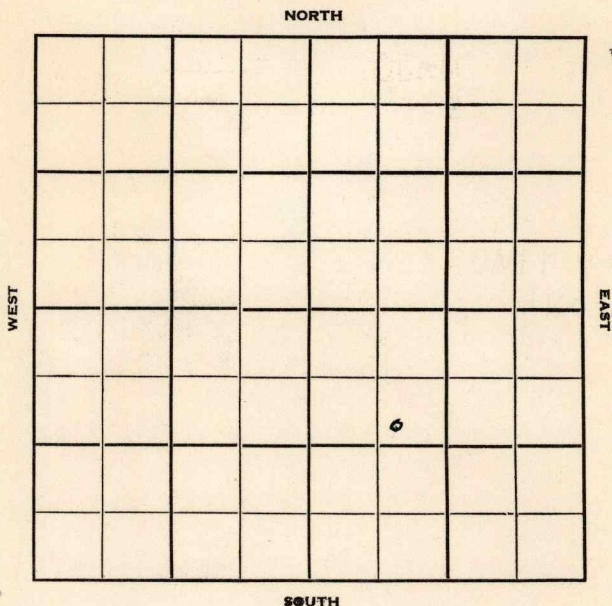


Section 26 Township 12 Range 22WWell No. 2 Schoenthaler OGALLAH UNIT 4-2Company Pyramid Drlg. & Bradley 11KCC

Trego

KANSAS

Sec. 26 Twp. 12 R. 22 W

Well No. # 2 Schoenthaler OGALLAH UNIT
4-2-KLL Farm

Pyramid Drlg. & Bradley Company

Pyramid Drlg. Contractor

Ogallah Pool


990 Ft. from N. Line

Ft. from S. Line

Ft. from E. Line

990 Ft. from W. Line

SE NW SE

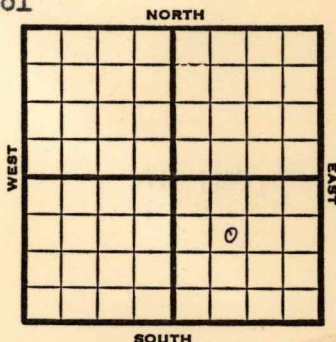

1951

Elev. 2336' REPORT

7/18

R U R

8/29

Spud 7-20-51

Oil Well TD 4013

8" @ 235 Anhy 1738

Top. 3370 Lans. 3604

Arb. 3991-98


5" @ 3993

TD 4013 FU 3200' oil S/14 boph

Comp. 381 bopd

COMPLETED

County Trego State Kansas
 Sec. 26 (Blk. 12 (Sur. 22W Map No.
 (Twp.) (Rge.)
 Operator Pyramid Drlg. & Bradley
 Well No. 2 Farm Schoenthaler OGALLAH UNIT
 Elev. Location SE NW SE 4-2-100

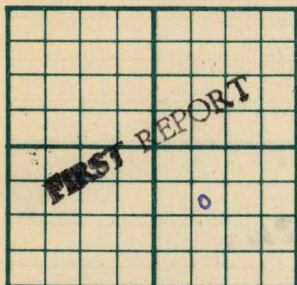

990 Ft. From N Line SE

920 Ft. From W Line Quarter

Ist. Report JUL 18 1951

Completion

Remarks

Pyramid Drlg. - Contr.

Spudding Date

Drlg. Data

Ogallah Pool

R U R

J. E. TYRA

County Trego State Kansas
 Sec. 26 (Blk.) 12 (Sur.) 22W Map No.
 Operator Pyramid Drlg. & Bradley
 Well No. 2 Farm Schoenthaler OGALLAH UNIT
 Elev. 2336 Location SE NW SE 4-6-1000



990 Ft. From N Line SE
990-Ft. From W Line Quarter

1st. Report

Completion AUG 29 1951

Remarks Ogallah Pool
Pyramid Drlg. - Contr.

Spudding Date 7-20-51

Drlg. Data Oil well TD 4013

8" @ 235 Anhy 1738 Top. 3370

Lans. 3604 Arb. 3991-98 5" @ 3993

TD 4013 FU 3200' oil S/ 14 boph

Comp. 381 bopd

J. E. TYRA