


Section 26 Township 12 Range 22W

Well No. #4 Schoenthaler

Company Pyramid Drlg.

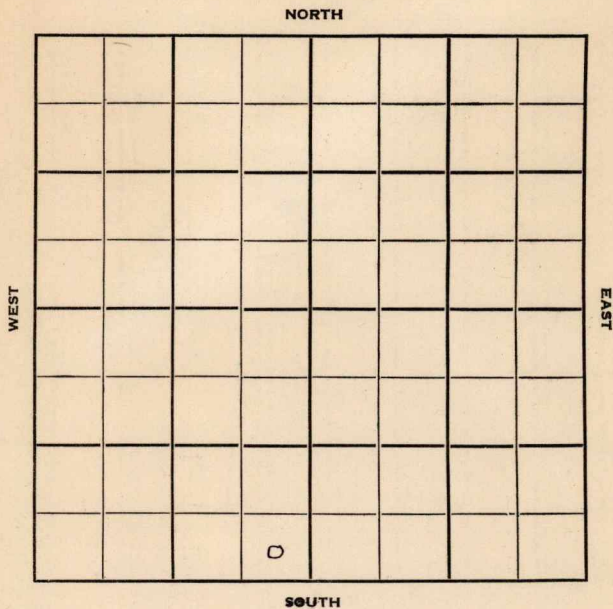

Trego

KANSAS

Sec. 26 Twp. 12 R. 22 W

Well No. # 4 Schoenthaler Farm

Pyramid Drlg. Company

Contractor


Ft. from N. Line

330 Ft. from S. Line

330 Ft. from E. Line

Ft. from W. Line

SE SE SW

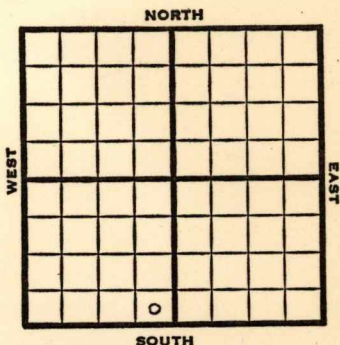

1951

Elev. 2343' REPORT

8/29

Location

1952

1/30

Oil Well TD 4020
9" @ 262

Top. 3367

Lans. 3600

Arb. 3982

TD 4011 5" @ 3988 DD 4020

S/ 18 BOPH Comp. 3000 BOPD

COMPLETED

County **Trego** State **Kansas**

Sec. 26 (Blk.) 12 (Sur.) 22W Map No.

Operator Pyramid Drlg.

Well No. 4 Farm Schoenthaler

Elev.	Location	SE	SE	SW
330 Ft. From S Line SW

330 Ft. From E Line Quarter

1st. Report AUG 29 1951

Completion

Remarks

Spudding Date _____

Drlg. Data

Location

J. E. TYRA

County Trego State Kansas

Sec. 26 (Blk. Twp.) 12 (Sur. Rge.) 22W Map No.

Operator Pyramid Drlg.

Well No. 4 Farm Schoenthaler

Elev.	2343	Location	SE SE SW
-------	------	----------	----------

COMPLETE

330 Ft. From S Line SW

330 Ft. From E Line Quarter

1st. Report

Completion JAN 30 1952

Remarks

Spudding Date

Drlg. Data Oil well TD 4020

9" @ 262 Top. 3367 Lans. 3600

Arb. 3982 TD 4011 5" @ 3988 DD 4020

S/ 18 boph Comp. 3000 bopd

J. G. McGEHEE