


Section 16 Township 33 Range 2E

Well No. 1 Roberts

Company Aladdin Pet.

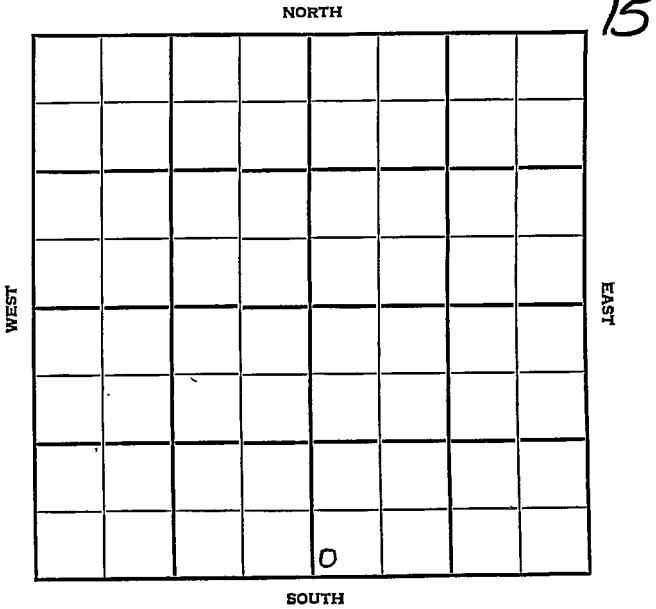

Summer

KANSAS

SEC.	16-	TWP.	33	R.	2E
------	-----	------	----	----	----

WELL NO.
#1 Roberts

FARM

COMPANY
Aladdin Pet.

CONTRACTOR
Crowe Drlg.

_____ Ft. from N. Line

_____ Ft. from S. Line

_____ Ft. from E. Line

_____ Ft. from W. Line

SW SW SE

1

NORTH

SOUTH

FIRST REPORT

1955	ELEVATION	REPORT
	1156'	
7/13	Spud 7-8-55 8" @120/125	Drlg1 1080
8/31	Comm 7-8-55 Layton KC BKC Marm Ce M Chert TD 8" @ 120/125 5 1/2" @ 3320/150 47/3255-63 CO frac 30 bo 50 bw 15 hr Comp 15 bopd 15 bw	2687 2831 3028 3144 3261 3320 CO S/1 bswph 500 A

COMPLETED

Co.

Company Aladdin Pet.

Farm Name Roberts No. 7

Use

No.

See

५

R.

1

County Summer Elev. 1156
 Sec. 16 Twp. 33 Rge. 2E
 Company Aladdin Pet.
 FarmName Roberts No. 1

TOPS	DEPTH	LOG	DATUM	Loc. in Sec.
Anh.				SW SW SE
TP.				
H.				
Tr.				
Dg.				
BL.				
L. <u>ruston</u>		<u>2687</u>	<u>1521</u>	Geol.
K.C. <u>1</u>		<u>2827</u>	<u>1775</u>	Contr.
B.K.C. <u>Marine</u>		<u>3028</u>	<u>1872</u>	
Ce.		<u>3144</u>	<u>1988</u>	<u>Crowe</u>
C.				Pool
M. <u>Chert</u>		<u>3261</u>	<u>2105</u>	
M.				
K.				
Mz.				
Mq.				
V.				
S.				
S.				
A.				
R.				
PE.				
G.				
T.D.	<u>3320</u>			0

COMPLETE

Date Comm. 7-8-55 AUG 31 1955

8" @ 120/125 5 1/2" @ 3320/150 CO

147/ 3255-63 S/ 1 bswph 500 A

CO, / free 30 bo 50 bw 15 hr.

Comp. 15 bond 15 bw