


Trego

KANSAS

SECTION 26 TOWNSHIP 12 RANGE 22 W

WELL NO. #8 Schoenthaler

COMPANY T. L. Ferrier

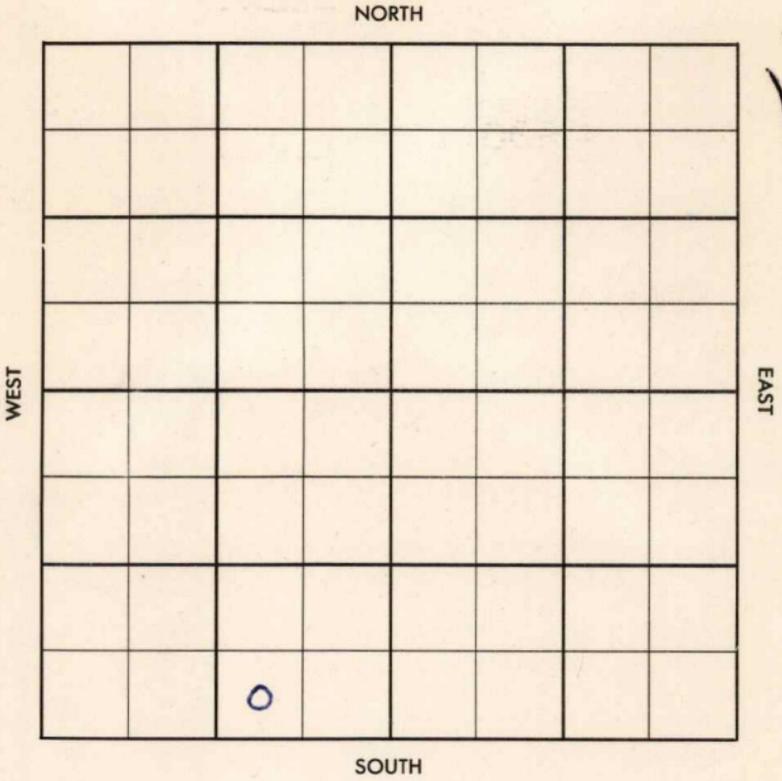

Trego

KANSAS

SEC.	TWP.	R.
26	12 ^S	22W

WELL NO. #8 Schoentholer FARM

COMPANY T. L. Ferrier

CONTRACTOR Walters

Ogallah


_____ Ft. from N. Line

_____ Ft. from S. Line

_____ Ft. from E. Line

_____ Ft. from W. Line

SW SE SW

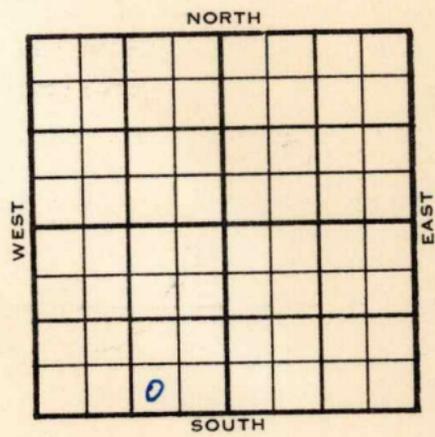

	ELEVATION	REPORT
1955	2347'	

10/26	Comm 10-19-55 8" @ 306 Drlg 2815	
11/4	Set 5 1/2" casing 3998 Top Anhy 1741 Top Lansing 3603 Top Arbuckle 3994 T.D. 4000 W.O.C. to set	
11/14	Drilled T.D. 4004 Filled up 1400' oil 1 hour No water Drilled T.D. 4008' Filled up 2500' Oil 3 hrs No water Filled up 3300' oil 7 hrs No water Running tubing and rods	
### 12-14	Comp. 348 BOPD Tp. 3372 H. 3572 L. 3600 A. 3994 TD 4000'	

COMPLETED

County Tyago Elev. _____
 Sec. 26 Twp. 12 Rge. 22W
 Company T. L. Ferrier
 Farm Name Schoenthaler No. 8

TOPS	DEPTH	LOG	DATUM	Loc. in Sec.
Anh.				SW SE SW
TP.				
H.				
Tr.				
Dg.				
Bl.				
L.				Geol. _____
K.C.				Contr. _____
B.K.C.				
Ce.				<u>Walters</u>
C.				
M.				Pool _____
M.				<u>Ogallah</u>
K.				
Mz.				
Mq.				
V.				
S.				
S.				
A.				
R.				
Pe.				
G.				
TD.				

FIRST REPORT
 OCT 26 1955

Date Comm. 10-19-55
8" @ 306 drlg. 2815

(Handwritten signature)

Co.
Lse.
No.
Sec.
T.
R.

County Trego Elev. 2347
 Sec. 26 Twp. 12 Rge. 22W
 Company T. L. Ferrier
 Farm Name Schoentholer No. 8

TOPS	DEPTH	LOG	DATUM	Loc. in Sec.																					
Anh.	<u>1741</u>			<u>SW SE SW</u>																					
Tp.	<u>3372</u>		<u>1025</u>																						
H.	<u>3572</u>		<u>1225</u>																						
Tr.																									
Dg.																									
Bl.																									
L.	<u>3600</u>		<u>1253</u>	Geol.																					
K.C.				Contr.																					
B.K.C.				<u>Walters</u>																					
Ce.				Pool																					
C.				<u>ogallah</u>																					
M.				<table border="1"> <tr><td></td><td></td><td></td></tr> <tr><td></td><td></td><td></td></tr> <tr><td></td><td></td><td></td></tr> <tr><td></td><td></td><td></td></tr> <tr><td></td><td></td><td></td></tr> <tr><td></td><td></td><td></td></tr> <tr><td></td><td></td><td></td></tr> </table>																					
M.																									
K.																									
Mz.																									
Me.																									
V.																									
S.																									
S.																									
A	<u>3994</u>		<u>1647</u>	COMPLETE																					
R.																									
Pe.																									
G.																									
T.D.	<u>4000</u>			<u>0</u>																					

Date Comm. 10-19-55 DEC 14 1955

8" @ 306 5 1/2" @ 3998 DD 4004

FU 1400' oil 1 hr. DD 4008

FU 2500' oil 3 hr. FU 3300' oil
7 hr. Comp. 348 bopd

Co.
Lse.
No.
Sec.
T.
R.