



Map No. KANGAR Sec. 36 Twp. 18 R. 8<sup>W</sup> ~~7<sup>W</sup>~~

Well No. 1- Root Farm \_\_\_\_\_

Continental Company


330 Ft. from N. Line

\_\_\_\_\_ Ft. from S. Line

990 Ft. from E. Line

\_\_\_\_\_ Ft. from W. Line

Elev. 1744

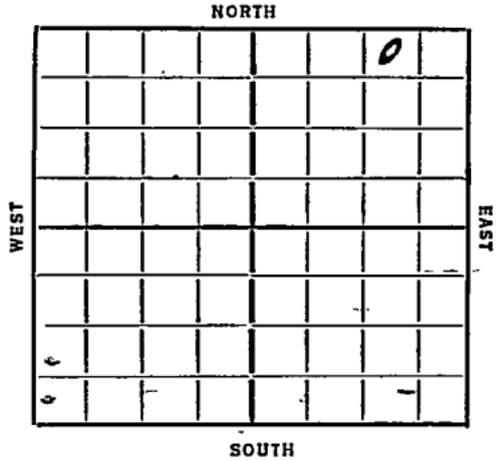

REPORT **O. W. D. D**

~~2/9/36~~  
 2/5 Roy.  
 2/14 Run  
 2/21 —  
 2/28 Dlg 1500 12" 172  
 3/6 " 2910  
 3/12 Top Wilcox 3154  
 T.D. 3181  
 Showed Oil thru rotary  
 cuttings 7" 3155 (Tel)  
 3/13 Rust H.F.O.  
 3/20 2500 oil-9hrs. ~~HP~~ Setting  
 tanks. T.D. 3181  
 3/27 B. Tanks.  
 4/2 Swabbing 40 bbls per hr. Reaming  
 hole.  
 4/10 Taking potential.  
 4/16 Pump 315 bbls 13 hours.  
 4/23 Building pumping rig.

OVER

4/29/36- Top Wilcox 3154'  
T.D. 3181'  
Pump 579 bbls.

COMPLETED

O. W. D. D

1936

6/3/36-Old total depth 3181'.

Drlg. 3190'.

6/11-Sil. 3190-94'.

7/8/36-Sil. 3190'

4000 gallons acid.

T.D. 3230'.

Potential 1839 bbls of Oil.

COMPLETED

Map No. 45 Sec. 36 Twp. 18 R. 7~~W~~

Well No. 1 - Root  
Continental Company

Contractor

SECTION PLAT

330 Ft. from N. Line

..... Ft. from S. Line

990 Ft. from E. Line

..... Ft. from W. Line

			0

FIRST REPORT

Location.....

Rig up.....

Drilling and Remarks:

*Rig on ground*

RECORD

Cased..... in., ..... ft.

Sand.....

Gas.....

Oil.....

Total Depth.....

PRODUCTION

1st 24 hrs. Nat.....

1st 24 hrs. after shot.....

Gas..... Cu. Ft.

Dry Hole.....

Abandoned.....

Date

FEB 5 1936

ORVAL MANNSCHRECK

.....192..... Scout

Map No. 45 Sec. 36 Twp. 18 R. SW

Well No. 1 Root

Continental Company

Contractor

SECTION PLAT

330 Ft. from N. Line

..... Ft. from S. Line

990 Ft. from E. Line

..... Ft. from W. Line

			6

**COMPLETED**

Location.....

Rig up.....

Drilling and Remarks:

*Top. Oil cont 315-4*

*Pump 57986*

RECORD

Cased..... in., ..... ft.

Sand.....

Gas.....

Oil.....

Total Depth..... 3181

PRODUCTION

1st 24 hrs. Nat.....

1st 24 hrs. after shot.....

Gas..... Cu. Ft.

Dry Hole.....


Abandoned.....

Date

APR 29 1936

192

Scout

 

*Rice*

Map No. 45 Sec. 36 Twp. 18 R. 8W

Well No. 1 Root.

Continental Company

Contractor

**SECTION PLAT**

			0

330 Ft. from N. Line

\_\_\_\_\_ Ft. from S. Line

990 Ft. from E. Line

\_\_\_\_\_ Ft. from W. Line

FIRST DEPOSIT

OW-117

**RECORD**

Location \_\_\_\_\_

Cased \_\_\_\_\_ in., \_\_\_\_\_ ft.

Rig up \_\_\_\_\_

Sand \_\_\_\_\_

Drilling and Remarks:

Gas \_\_\_\_\_

*Old 117 3181*

Oil \_\_\_\_\_

*July 3190*

Total Depth \_\_\_\_\_

**PRODUCTION**

1st 24 hrs. Nat. \_\_\_\_\_

1st 24 hrs. after shot \_\_\_\_\_

Gas \_\_\_\_\_ Cu. Ft.

Dry Hole \_\_\_\_\_

Abandoned \_\_\_\_\_

Date

JUN 3 1936 19

S. J. LEWIS Scout

Map No. 45 Sec. 36 Twp. 18 R. 8W

Well No. 1 Rwy.

Continental Company

Contractor

**SECTION PLAT**

			0

320 Ft. from N. Line

\_\_\_\_\_ Ft. from S. Line

990 Ft. from E. Line

\_\_\_\_\_ Ft. from W. Line

**COMPLETED**

Location \_\_\_\_\_

Rig up \_\_\_\_\_

Drilling and Remarks:

*8162190*  
*4000 acid*  
*Rwy. 1889*

**RECORD**

Cased \_\_\_\_\_ in., \_\_\_\_\_ ft.

Sand \_\_\_\_\_

Gas \_\_\_\_\_

Oil \_\_\_\_\_

Total Depth 3230

**PRODUCTION**

1st 24 hrs. Nat. \_\_\_\_\_

1st 24 hrs. after shot \_\_\_\_\_

Gas \_\_\_\_\_ Cu. Ft.

Dry Hole \_\_\_\_\_

Abandoned \_\_\_\_\_

Date

JUL 8 1936 19

S. J. LEWIS

Scout