


Section 26 Township 12 Range 22 W

Well No. # 2 Scott

Company Texas

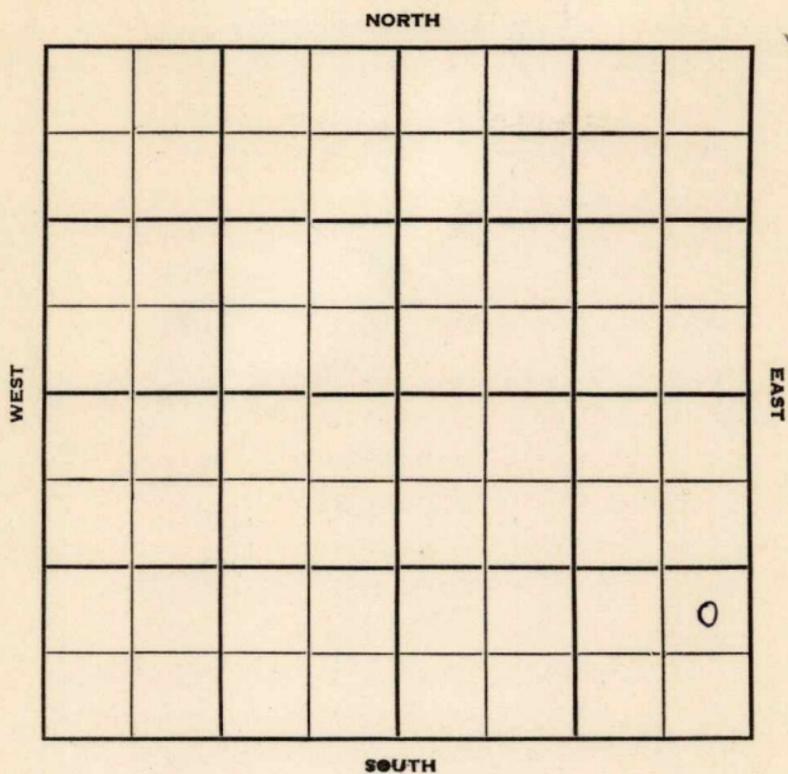

Sec. 26 Twp. 12 R. 22 W

Well No. # 2 Scott Farm

Texas Company

Powell Drlg. Contractor

Ogallah


Ft. from N. Line

990 Ft. from S. Line

330 Ft. from E. Line

Ft. from W. Line

NE SE SE

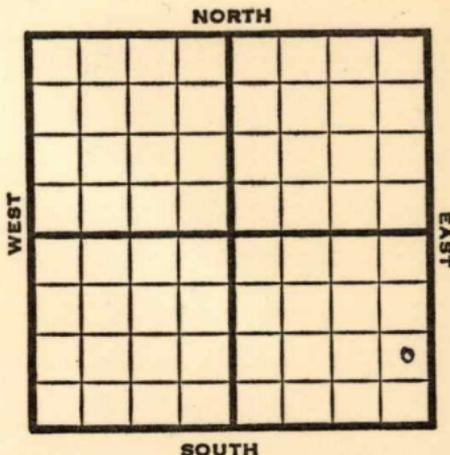

1951

Elev. 2346' REPORT

7/11

Spud 7-4-51
10" @ 513
Drlg. 2384'

8/15

Spud 7-4-51
Oil well TD 4028' 10" @ 513'
Top 3374'
DST 3373-79' open 1 hr. rec 50' HOCM
210' SW
Lans. 3605'
DST 3609-20', failed.
DST 3599-3620 open 1 hr, rec 230' SW
Cored 3980-81, rec 9" sh.
Cored 3981-97 rec 6' grey sh.
Arb. 3987'
Cored 3987-4028' rec 2' white sdy dol.
1' sdy shly dol. w/sat. 24' sdy dol.
w/sat. 2' white to grey dol. 2' sdy
dol w/sat.
TD 4028' 7" @ 4025 CO to 4028'
FU 1500' oil 24/3992-98' 4/4000-02
88/4005-26 FU 3100' oil S/64 BOPH
P/365 BOPD
Comp. EPI pot. 3000 BOPD

COMPLETED

