


Rice

Section 36 Township 18 Range 8-W

Well No. 1 Warner "A"

Company Continental et al

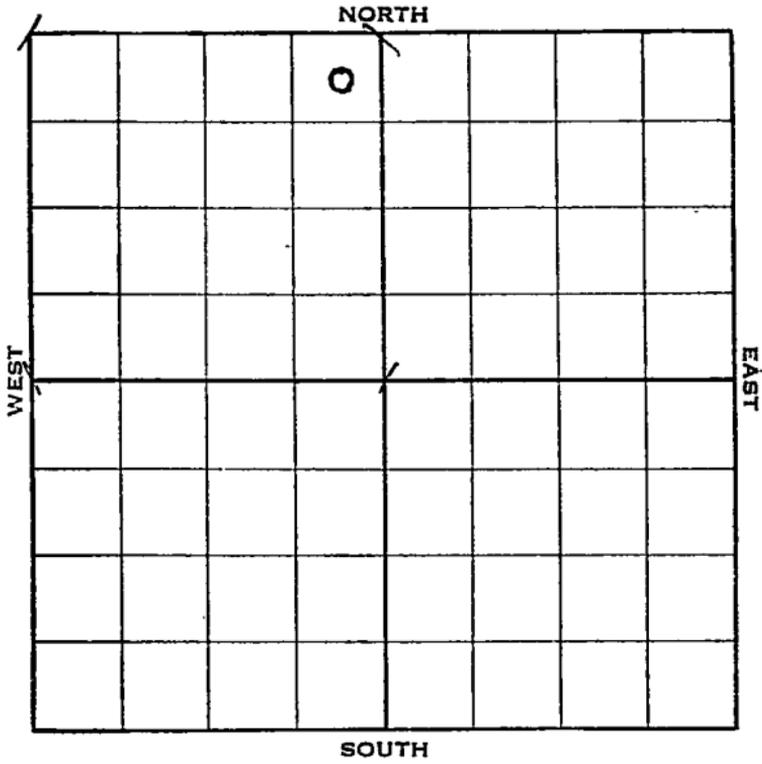

Rice

KANSASMap No. _____ Sec. 36 Twp. 18 R. 8WWell No. 1 Warner "A"
_____ Continental etal _____ Company~~FIRST REPORT~~ _____ Contractor

NE NW


330 Ft. from N. Line

_____ Ft. from S. Line

330 Ft. from E. Line

_____ Ft. from W. Line

SECTION PLAT

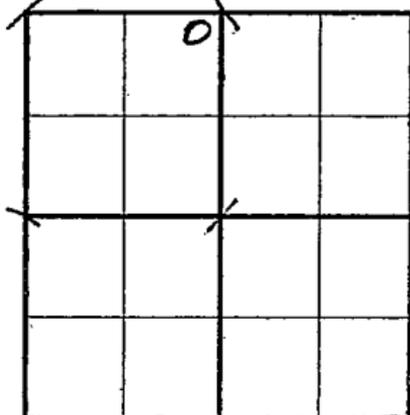Location X

Rig up _____

Drilling and Remarks:

RECORD

Cased _____ in., _____ ft.

Sand _____

Gas _____

Oil _____

Total Depth _____

PRODUCTION

1st 24 hrs. Nat. _____

1st 24 hrs. after shot _____

Gas _____ Cu. Ft.

Dry Hole _____

Abandoned _____

Date

FEB 9 1938 19 _____ H. D. Hatfield Scout

Rice

KANSAS

Map No. 45 Sec. 36 Twp. 18 R. 8W

Well No. 1 Warner "A"

Continental etal Company

Contractor

COMPLETED
NE NW

SECTION PLAT

	0		

330 Ft. from N. Line

_____ Ft. from S. Line

330 Ft. from E. Line

_____ Ft. from W. Line

Location _____

Rig up _____

Drilling and Remarks:

2000 acid

POT 2570

RECORD

Cased 7 in., 3156 ft.

Sand Arb 3156

Gas _____

Oil _____

Total Depth 3216

PRODUCTION

1st 24 hrs. Nat. _____

1st 24 hrs. after shot _____

Gas _____ Cu. Ft.

Dry Hole _____

Abandoned _____

Date

MAR 23 1938

19

H. D. Hatfield

Scout