


Section 26 Township 12 Range 22 W

Well No. # 5 Schoenthaler *OGALLALA UNIT*  
*4-5-1000*

Company Pyramid Oil

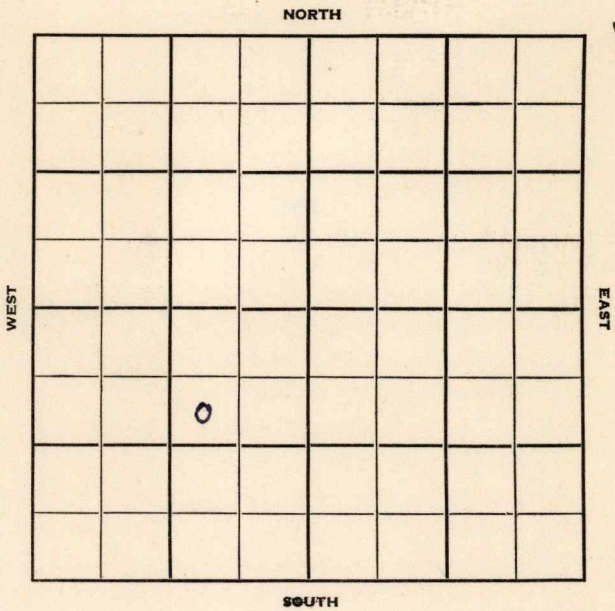

Trego **KANSAS**

Sec. 26 Twp. 12 R. 22 W

OGALLALA UNIT

Well No. # 5 Schoenthaler 4-S-1000 Farm

Pyramid Oil Company

Pyramid Contractor


990 Ft. from N. Line

\_\_\_\_\_ Ft. from S. Line

990 Ft. from E. Line

\_\_\_\_\_ Ft. from W. Line

SW NE SW

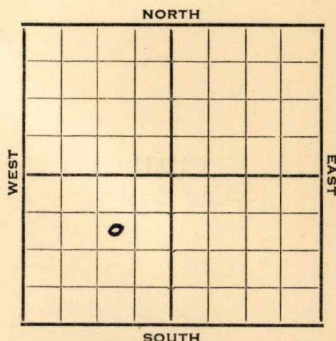

1952

**Elev. 2350'** REPORT

- 6/11 Spud 5-31-52  
8" @ 302' **Anhy 1748'**  
Pulled derrick @ 3025'
- 6/18 Drlg 3025'
- 6/25 **Topeka 3376'**  
Drlg. 3561'
- 7/2 **Heeb. 3574** **Lans. 3608**  
**BKC 3849** **Cong. 3951**  
**Arb. 4014** **RTD 4020**  
5" @ 4016
- 7/9 DD 4027 fill up 1500 Oil 6 hrs  
500 A
- 7/17 S/16 BOPH DD 4032
- 7/23 NR
- 7/30 Spud 5-31-52  
Oil well TD 4032' 8" @ 302  
**Anhy 1748'** **Top 3376'** **Heeb 3574'**  
**Lans. 3608'** **B KC 3849'** **Cong. 3951**  
**Arb. 4014'** **TD 4020'** **5" @ 4016**  
DD 4027 FU 1500' oil 6 hr. 500 A  
S/16 BOPH DD 4032  
Comp. 349 BOPD

**COMPLETED**



County Trego State Kansas  
 Sec. 26 (Blk. 12) (Sur. 22W) Map No.           
 Operator Pyramid Oil OGALLAH UNIT 4-5-KCC  
 Well No. 5 Farm Scheenthaler  
 Elev. 2350 Location SW NE SW


**COMPLETE**

0

990 Ft. From N Line SW  
 990 Ft. From E Line Quarter  
 Ist. Report           
 Completion JUL 30 1952  
 Remarks           
Pyramid - Contr.  
 Spudding Date 5-31-52

Drlg. Data Oil well TD 4032  
8" @ 302 Anhy 1748 Top. 3376  
Heeb. 3574 Lans. 3608 B KC 3849  
Cong. 3951 Arb. 4014 TD 4020 5" @ 4016  
DD 4027 FU 1500' oil 6 hr. 500 A  
S/ 16 boph DD 4032  
Comp. 349 bopd