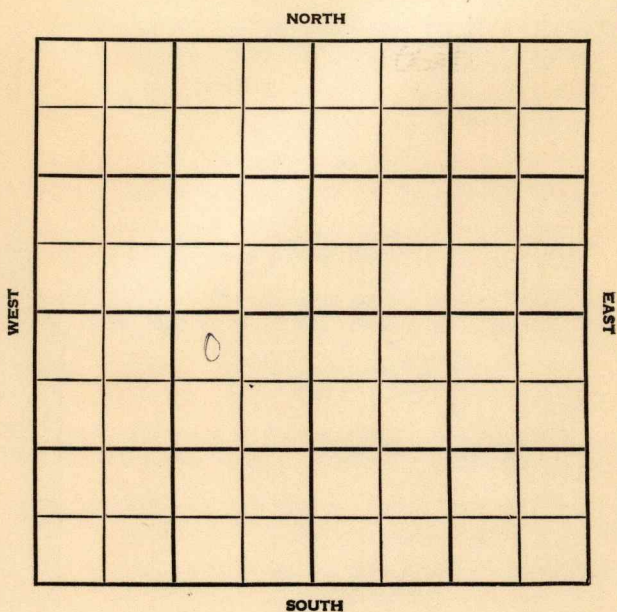


Section 26 Township 12 Range 22WWell No. #9 SchoenthalerCompany T.L. Ferrier

County Trego Elev. _____
Sec. 26 Twp. 12 Rge. 22W
Company T. L. Ferrier
Farm Name Schoenthaler No. 9

TOPS	DEPTH	LOG	DATUM
Anh.			
TP.			
H.			
Tr.			
Dg.			
BL.			
L.			
K.C.			
B.K.C.			
Ce.			
C.			
M.			
M.			
K.			
Mz.			
Me.			
V.			
S.			
S.			
A.			
R.			
Pe.			
G.			
T.D.			

Loc. in Sec. NW NE SW
Geol. _____
Contr. _____
Walters Drlg.
Pool _____
Ogalla

FIRST REPORT
O
24 56

Date Comm. spd. 10-19-56
8" @ 303, Drlg. 2525

NOV 25 1956

R. G.

County Trego Elev. 2340
 Sec. 26 Twp. 12 Rge. 22W
 Company T. L. Ferrier
 Farm Name Schoenthaler No. 9

TOPS	DEPTH	LOG	DATUM	Loc. in Sec.
Anb.	1742			NW NE SW
Tp.	3373			
H.	3572			
Tr.				
Dg.				
Bl.				
L.	3605			Geol.
K.C.				
B.K.C.	3843			Contr.
Ce.				Walters Drlg.
C.				
M.				Pool
M.				Ogalla
K.				
Mz.				
Mo.				
V.				
S.				
S.				
A.	4018			
R.				
PE.				
G.				
T.D.	4030			

COMPLETE

Date Comm. spd. 10-19-56

8" @ 303, Drlg. 2525

OCT 31 '56

Circ @

4015 NOV 7 '56

5 1/2 4022 WOC

NOV 13 '56

CO 4030 & 3 1/2 BO no time

1/2 & 7 1/2 Boph 5 hrs Pop

NOV 21 '56

NOV 28 '56

P. 5 Boph for

48 hrs. DEC 5 '56 DEC 12 '56 Ph P. 149

Boph no/w gran 36°