

Rice

Section 36 Township 18 Range 8-WWell No. 2 JonesCompany Continental et al

				0			

NORTH

WEST

EAST

SOUTH

KANSAS

Rice

Sec. 36 Twp. 18 R. 8-W

Well No. #2 Jones Farm

Continental et al _____ Company


330 Ft. from N. Line

Ft. from S. Line

_____ Ft. from E. Line

330 Ft. from W. Line

Elev. 1726

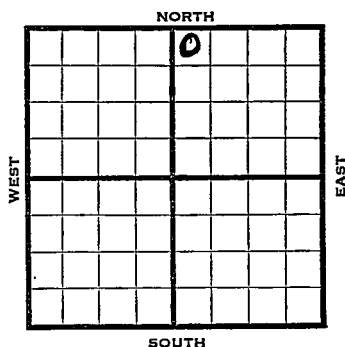

19 38

REPORT

3/30

R. R.

4/8

10" @ 200'. Drlg. 1305!.

4/15

K.C. 2805'. Arb. 3135'.

T.D. 3138', S.O. Rng. 7".

4/22

7" @ 3136', T.D. 3138',

2800' oil 4 hrs. Drlg. 3139'.

4/27

7th @ 3136'.

Arb. 3135'.

T.D. 32161.

2000 acid.

Potential 2620:bbls.

COMPLETED

Rice

KANSAS

Map No. 45 Sec. 36 Twp. 18 R. 8WWell No. 2 JonesContinental etal

Company

Contractor

FIRST REPORT

NW NE

330 Ft. from N. Line Ft. from S. Line Ft. from E. Line330 Ft. from W. Line

SECTION PLAT

		0	

Location Rig up

Drilling and Remarks:

RR

RECORD

Cased in., ft.Sand Gas Oil Total Depth

PRODUCTION

1st 24 hrs. Nat. 1st 24 hrs. after shot Gas Cu. Ft.Dry Hole Abandoned

Date

MAR 30 1938

19

H. D. Hatfield Scout

Rice KANSAS

Map No. 45 Sec. 36 Twp. 18 R. 8WWell No. 2 JonesContinental etal Company

Contractor

COMPLETED

NW NE

330 Ft. from N. Line Ft. from S. Line Ft. from E. Line330 Ft. from W. Line

SECTION PLAT

		0	

Location Rig up

Drilling and Remarks:

*2000 acid**POT 2620*

RECORD

Cased 7 in. 3136 ft.Sand ARB 3135Gas Oil Total Depth 3216

PRODUCTION

1st 24 hrs. Nat. 1st 24 hrs. after shot Gas Cu. Ft.Dry Hole Abandoned

Date

APR 27 1938

19

H. D. Hatfield Scout