


Section 26 Township 12 Range 22W

Well No. #1 V. G. Powers OGALLALA UNIT
S-1
11CCC

Company Texas Co.

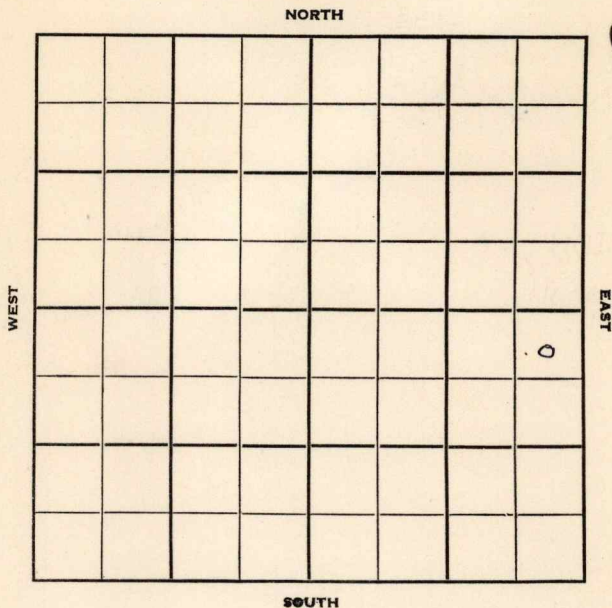

Trego

KANSAS

Sec. 26 Twp. 12 R. 22 W

Well No. # 1 V. G. Powers OGALLAH UNIT S-1 1000 Farm

Texas Company Company

Noble Drlg. Contractor

Ogallah Pool


330 Ft. from N. Line

Ft. from S. Line

330 Ft. from E. Line

Ft. from W. Line

NE NE SE

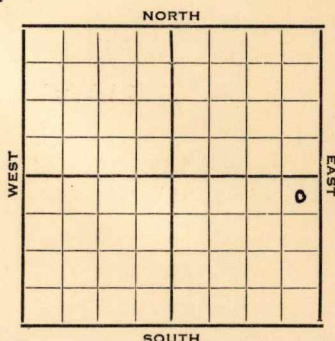

1951

Elev. 2365' REPORT

12/5

Spud 12-31-51
8" @ 508' WOC

1952
1/2

Spud 12-1-51
Oil Well TD 4040
8" @ 508'
Top. 3400 Heeb. 3599
KC 3632 Arb. 4021-26
5" @ 4021 TD 4040
S/ 56 BOPH
Comp. 2822 BOPD

COMPLETED

County Trego State Kansas
 Sec. 26 (Blk. 12) (Sur. 22W) Map No.
 Operator Texas Company OGALLAH UNITS-1
 Well No. 1 Farm V. G. Powers '1000
 Elev. _____ Location NE NE SE

FIRST REPORT

330 Ft. From N Line SE

330 Ft. From E Line Quarter

1st. Report DEC 5 1951

Completion _____

Remarks _____

Noble Drlg. - Contr.

Spudding Date 12-31-51

Drlg. Data _____

Ogallah Pool

8" @ 508 WOC

J. E. TYRA