


KANSAS

Section 36 Township 18 Range 8W

Well No. #3 Root

Company Continental et al
Geneseo Pool

NORTH

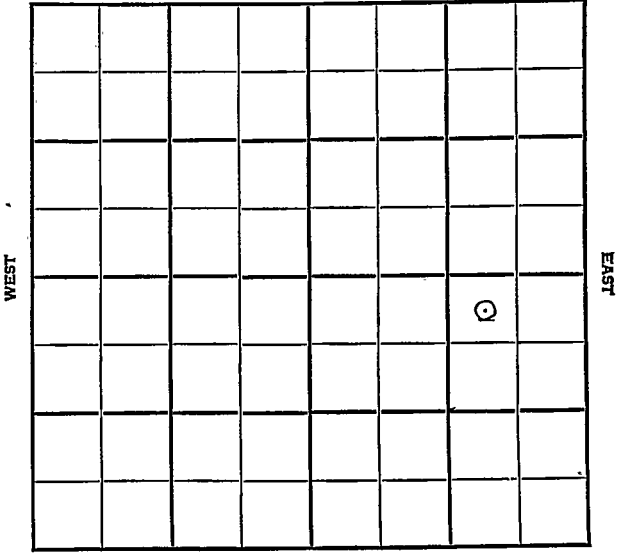

SOUTH

Sec. 36 Twp. 18 R. 8W

Well No. #3 Root Farm


Continental et al Company
Geneseo

330 Ft. from N. Line

_____ Ft. from S. Line

990 Ft. from E. Line

_____ Ft. from W. Line

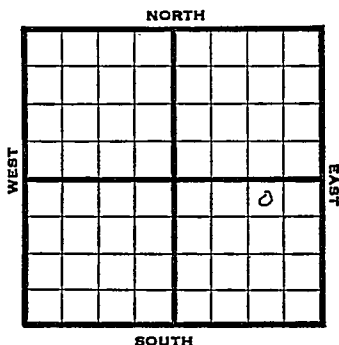

NW NE SE

1948 **REPORT** Elev. 1743'

- 4/14 RUR
- 4/21 10" @ 377'
Drlg. 2340'
- 4/28 Arbuckle 3243-45'
TD 3245'
6" @ 3244'
RUST
- 5/5 PB 3100'
23 shots 2980-90'
1000 acid HFW
- 5/12 Simp. 3182'
TD 3249'
Abd.

ABANDONED

Map No. _____ Sec. 36 Twp. 18 R. 8W

Well No. 3 Root

_____ Continental et al. _____ Company

_____ **FIRST REPORT** _____ Contractor

NW NE SE

SECTION PLAT

330 Ft. from N. Line

_____ Ft. from S. Line

990 Ft. from E. Line

_____ Ft. from W. Line

			o

Rice County

Location _____

Rig up _____

Drilling and Remarks:

R U R

RECORD

Cased _____ in., _____ ft.

Sand _____

Gas _____

Oil _____

Total Depth _____

PRODUCTION

1st 24 hrs. Nat. _____

1st 24 hrs. after shot _____

Gas _____ Cu. Ft.

Dry Hole _____

Abandoned _____

Date

APR 14 1948 19

S. J. LEWIS Scout

Map No. 45 Sec. 36 Twp. 18 R. 8W

Well No. 3 Root

Continental etal. Company

ABANDONED

Contractor

NW NE SE

E 11743
SECTION PLAT

330 Ft. from N. Line

 Ft. from S. Line

990 Ft. from E. Line

 Ft. from W. Line

			o

Rice County

Location

Rig up

Drilling and Remarks:

Swij 8/82.

RECORD

Cased in., ft.

Sand

Gas

Oil

Total Depth 3249

PRODUCTION

1st 24 hrs. Nat.

1st 24 hrs. after shot

Gas Cu. Ft.

Dry Hole

Abandoned

Date

MAY 12 1948

19

S. J. LEWIS Scout