

Section 27 Township 12 Range 22 W

Well No. # 1 Bittle (OGALLAH UNIT) 1-4

Company Texas Co. KCC

NORTH

//

WEST

EAST

0

SOUTH

Trego

KANSAS

Sec. 27 Twp. 12 R. 22W ✓

Well No. #1 Bittle (OGALLAH UNIT) 1-4 Farm KCC

Texas Co. Company

Noble -Contr. Contractor

Ogallah


990' Ft. from N. Line

_____ Ft. from S. Line

330' Ft. from E. Line

_____ Ft. from W. Line

SE NE SW

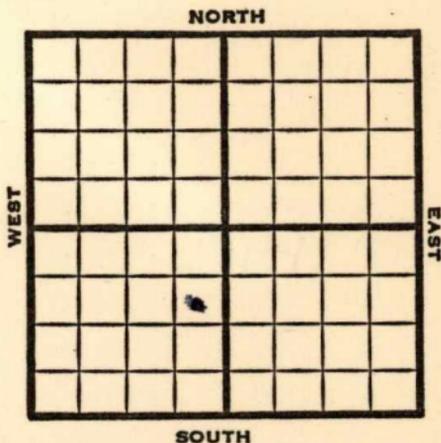

1951

Elev. 2347' REPORT

10/17

Spud 10-12-51

8" @ 507

Drlg. 1477'

11/28

Spud 10-12-51

Oil Well TD 4048

8" @ 507

Top 3382 Heeb. 3575

Lans. 3608 Arb. 4017

TD 4048 50/ 4032-48

S/ 25 GOPH 500 A

S/ 99 BO 6 hr. SP 4028

27/ 4018-27 500 A

S/ 50 BO 1 hr. CO 60 4048

Comp. Depthro. pot. 1597 BOPD

823 BW

COMPLETED

