



KANSAS

Rice



Sec. 36 Twp. 18 R. SW

Well No. #6 R. Warner "A" Farm

Continental et al

Company

Geneseo Pool


330' Ft. from N. Line

Ft. from S. Line

1320' Ft. from E. Line

Ft. from W. Line

C N L NW

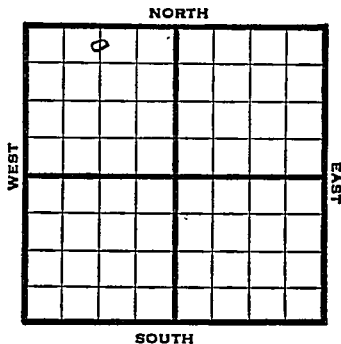

1948

Elev. 1744' REPORT

5/26 Location

6/1 Derrick

6/9 "

6/16 10" @ 382'  
WOC

6/23 Drlg 3147'

6/29 Arbuckle 3186'  
TD 3191'  
7" @ 3187'  
RUST

7/8 Arbuckle 3186'  
7" @ 3187'  
2000 Acid  
Echo Pot. 3000 Pot.  
Gr. 42°  
TD 3204'

**COMPLETED**

Map No. \_\_\_\_\_ Sec. 36 Twp. 18 R. 8W

Well No. 6 R. Warner "A"

Continental etal. Company

**FIRST REPORT**

Contractor

C N L NW


SECTION PLAT

330 Ft. from N. Line

\_\_\_\_\_ Ft. from S. Line

1320 Ft. from E. Line

\_\_\_\_\_ Ft. from W. Line

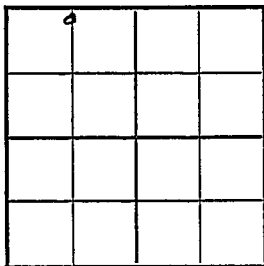

Rice County

RECORD

Location X

Rig up \_\_\_\_\_

Drilling and Remarks:

Cased \_\_\_\_\_ in., \_\_\_\_\_ ft.

Sand \_\_\_\_\_

Gas \_\_\_\_\_

Oil \_\_\_\_\_

Total Depth \_\_\_\_\_

PRODUCTION

1st 24 hrs. Nat. \_\_\_\_\_

1st 24 hrs. after shot \_\_\_\_\_

Gas \_\_\_\_\_ Cu. Ft.

Dry Hole \_\_\_\_\_

Abandoned \_\_\_\_\_

Date

MAY 26 1948

19

S. J. LEWIS Scout

Map No. 45 Sec. 36 Twp. 18 R. 8W

Well No. 6 R. Warner "A"

Continental etal. Company

COMPLETE

Contractor

C N L NW

*E11244*  
SECTION PLAT

330 Ft. from N. Line

\_\_\_\_\_ Ft. from S. Line

1320 Ft. from E. Line

\_\_\_\_\_ Ft. from W. Line

	⊕		

Rice County

Location \_\_\_\_\_

Rig up \_\_\_\_\_

Drilling and Remarks:

*Cr 8186*  
*7" @ 3187*  
*2000 cu ft*

*Echo B + 3000*

*42 2/3*

RECORD

Cased \_\_\_\_\_ in., \_\_\_\_\_ ft.

Sand \_\_\_\_\_

Gas \_\_\_\_\_

Oil

Total Depth 3204

PRODUCTION

1st 24 hrs. Nat. \_\_\_\_\_

1st 24 hrs. after shot \_\_\_\_\_

Gas \_\_\_\_\_ Cu. Ft.

Dry Hole \_\_\_\_\_

Abandoned \_\_\_\_\_

Date

JUL 8 1948 19

S. J. LEWIS Scout