

DX 78-1

Rice


O. W. P. B KANSAS

Section 36 Township 18 Range 8W

Well No. #5 E.W. Root

Company Continental et al

NORTH

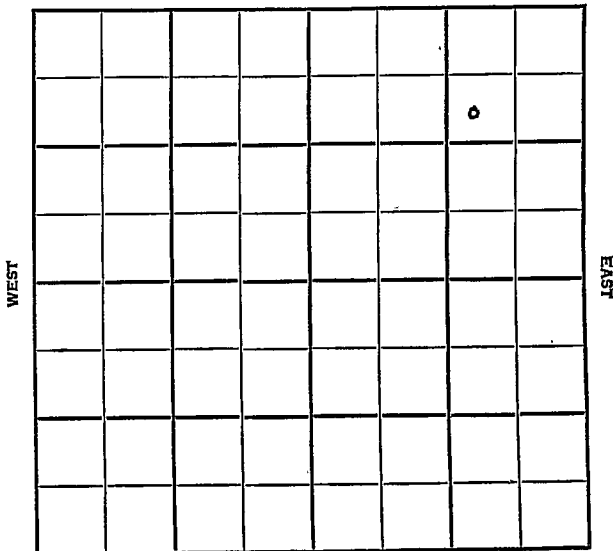

SOUTH

SEC. 36	TWP. 18	R. 8W
------------	------------	----------

WELL NO. #5 E.W. Root FARM

COMPANY Continental Oil et al


CONTRACTOR Lohman & Johnson

990 _____ Ft. from N. Line
Geneseo Pool

_____ Ft. from S. Line

990 _____ Ft. from E. Line

_____ Ft. from W. Line

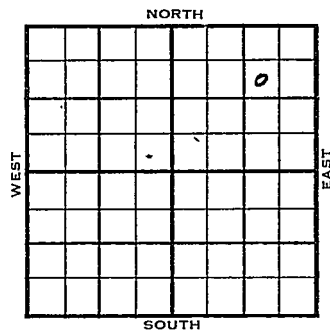

SW NE NE

1954	ELEVATION 1746'	REPORT
------	--------------------	--------

10/13 Spud 10-10-54
8" @ 316'
Dr lg. 1400'

11/23 Spud 10-10-54
Oil Well
TD 3222'
8" @ 316'
Heeb 2657', Br. Lime 2785', Lans 2818'
Simp sh. 3167', Simp Sd. 3175'
DST 3177'-95' opn 1 hr, rec 240' ho & gcm 230# Arb. 3212'
DST 3214'-21' opn 15 min, rec 600' free oil, 71' ho & gcm 450#
TD 3222'
5" @ 3215'
Schlumberger Tops: Heeb 2657', Br. Lime 2786', Lans 2818' Simp 3164' Simp Sd. 3175', Arb. 3212'
TD 3222'
S/ 140 bo 7 hr.
Comp 78 bopd 7% Wtr.

COMPLETED

1956

O. W. P. B

4-18

OTD 3222'

5" @ 3215, 24/ 318 7-93, frac

PB 3185, 8/ 3182-84, 8/ 3176-78, frac

CO 3205

Comp. 80 bopd

S. 3164

A. 3212

FIRST REPORT

d

COMPLETED

O. W. P. B.

FORM 513 SUNRA

OWPB

County Rice Elev. 1749 Co.
 Sec. 36 Twp. 18 Rge. 8W
 Company Continental Oil
 Farm Name Root No. 5

TOPS	DEPTH	LOG	DATUM
Anh.			
Tr.			
H.			
Tr.			
Dg.			
Bl.			
L.			
K.C.			
B.K.C.			
Ce.			
C.			
M.			
M.			
K.			
Mz.			
Ma.			
V.			
S.	3161		
S.			
A.	3212		
R.			
PE.			
G.			
T.B.	3222		

Loc. in Sec. SW NE NE
 Geol.
 Contr.
 Pool Genesee-Edwards

			✓
FIRST REPORT			
APR 18 1948			
COMPLETE			

Date Comm. 5th @ 3215 2 1/2 3187-93 frac PB 3185
8/ 3182-8 1/2 8/ 3176-78 frac GO 3205
Comp. 80 bond

3187 2 1/2 89A

10

Co. No. Sec. T. R.