

KANSAS


FORM 51 5M 1-42 PETROL

Rice

Section 36 Township 18 Range 8-W

Well No. #5 R. J. Werner-"A"

Company Continental etal

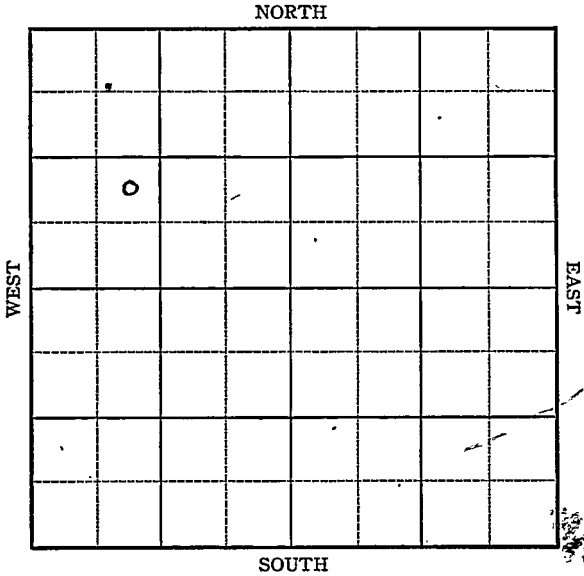


Sec. 36 Twp. 18 R. 8-W

Well No. #5 R. J. Warner "A" Farm

Continental etal Company

NORTH

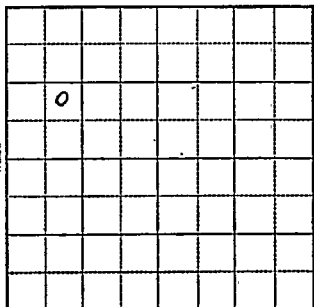

_____ Ft. from N. Line

990 Ft. from S. Line

_____ Ft. from E. Line

990 Ft. from W. Line

Elev. 1751

SOUTH

1943

R E P O R T

9/29 Derrick

10/6 "otary

10/13 10" @ 203
Drlg. 1692'

10/20 Drlg. 3125'

11/3 2650' oil in 2 hrs.

11/10 Arb 3184
7" @ 3187
Depth Pot. 3660'
T.D. 3218'
Max. 3000
Gravity 40.1

COMPLETED

Rice

KANSAS

Map No. 45 Sec. 36 Twp. 18 R. 8W

Well No. 5 R. J. Warner "A"

Continental etal. Company

COMPLETED Contractor

NE SW NW

SECTION PLAT

o			

Ft. from N. Line

990 Ft. from S. Line

Ft. from E. Line

990 Ft. from W. Line

Geneseo Pool

Location _____

Rig up _____

Drilling and Remarks:

*Core 3154
7" @ 3157
Inject to 3660
Max 3000*

40 = 214

RECORD

Cased _____ in., _____ ft.

Sand _____

Gas _____

Oil _____

Total Depth 3218

PRODUCTION

1st 24 hrs. Nat. _____

1st 24 hrs. after shot _____

Gas _____ Cu. Ft.

Dry Hole _____

Abandoned _____

Date

NOV 10 1943 19

S. I. LEWIS Scout