


Trego

Section 27 Township 12 Range 22W

KANSAS

Well No. #10 Geo. Bittel

Company Texas Company

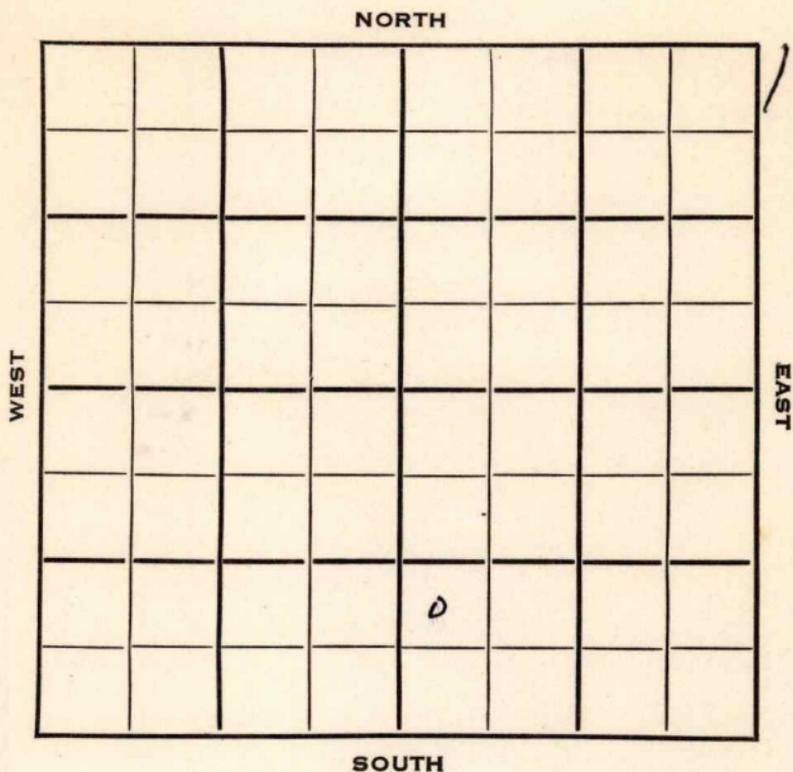

Trego

KANSAS ✓

Sec. 27 Twp. 12 R. 22 W

Well No. # 10 Geo. Bittel Farm

Texas Company Company

Powell Drlg. Contractor


         Ft. from N. Line

990 Ft. from S. Line

         Ft. from E. Line

330 Ft. from W. Line

NW SW SE

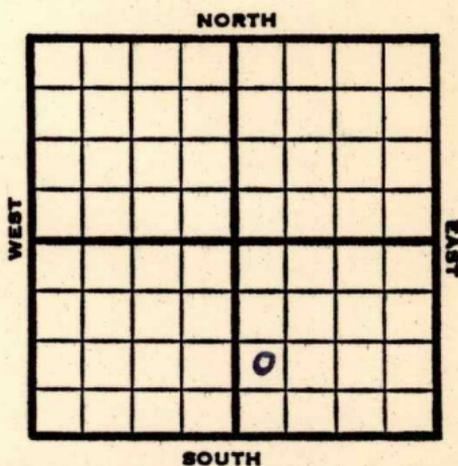

1953 **Elev. 2338'** REPORT

2/4 Spud 2-1-53  
10" @ 239 WOC

2/12 Drlg. 3590'

2/19 **Arb. 4005'** Cored 4010-40, 30'  
TD 4040' 7" @ 4010

2/26 **Top 3350' Heeb 3570' Lans 3603'**  
**Arb. 4005'** TD 4040' CO 4040'  
FU 1000' oil, 1 hr,  
S/101 BO 2 hrs.

3/4 Spud 2-1-53  
Oil Well  
TD 4040  
10" @ 239  
**Top 3350, Heeb 3570, Lans 3603,**  
**Arb 4005,**  
TD 4040  
7" @ 4010  
CO to 4040  
FU 1000' oil 1 hr.  
S/101 bo 2 hrs.  
Comp. 1563 bopd

**COMPLETED**



