

Rice

DX 78-1

KANSAS

Section 36 Township 18 Range 8W

Well No. #8 R.J. Warner "A"

Company Continental Oil

NORTH

			o						

SOUTH

Rice

KANSAS

SEC.	TWP.	R.
36	18	8 W

WELL NO.

8 R. J. Warner "A"

FARM

COMPANY

Continental et al

CONTRACTOR

G_M_R Tools

Geneseo Pool


990 Ft. from N. Line

Ft. from S. Line

330 Ft. from E. Line

Ft. from W. Line

SE NE NW

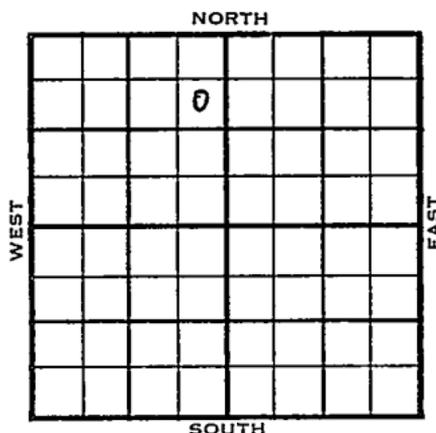

	ELEVATION	REPORT
1954	1745'	

9/15 Spud 9-10-54
8" @ 305 w/160
Drlg. 2594'

10/6 Spud 9-10-54
Oil Well
TD 3179'
8" @ 305'
Heeb 2654 Br. Lime 2780', Lans 2810'
Arb. 3176'
DST 3178'-81' opn $\frac{1}{2}$ hr, rec 320' oil
430#
TD 3179'
5" @ 3176'
CO to 3179'
S/ 84 bo 24 bw 6 hr.
Schlumberger Tops; Heeb 2653', Br. Lime
2779', Lans 2811' Arb. 3176'
Comp 51 bopd 55% Wtr.

COMPLETED

