


DX 78-1 Trego

Section 27 Township 12S Range 22W  
Well No. #11 Geo. Bittell OGALLALA UNIT 1-11  
Company The Texas Co 1  
KCC

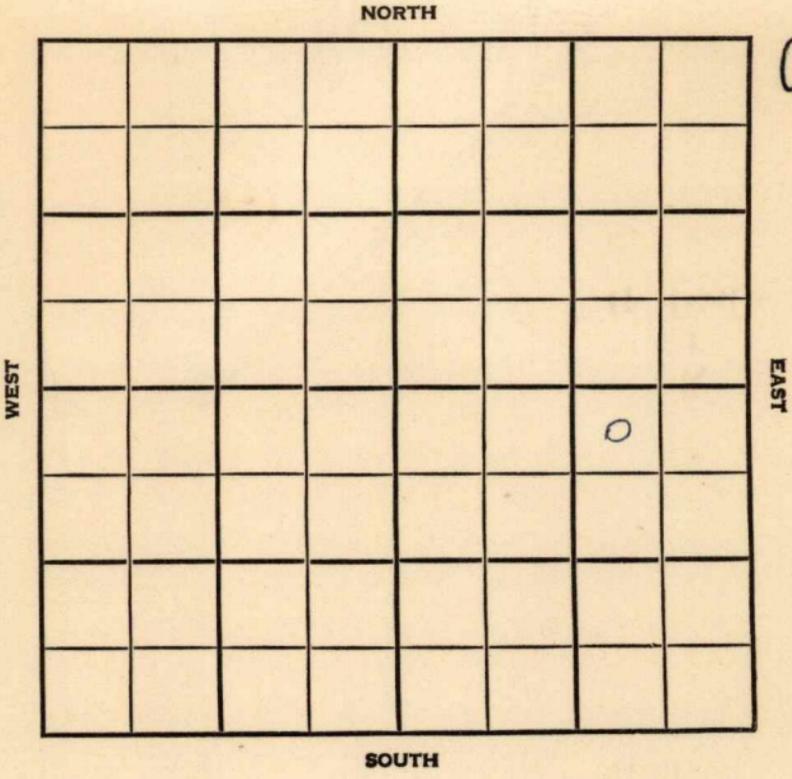

Trego

KANSAS

SEC. 27	TWP. 12	R. 22W
------------	------------	-----------

WELL NO. #11 Geo. Bittel **OGALLAH UNIT**  
2-11-1000 FARM

COMPANY The Texas Company

CONTRACTOR Stickle


Ogallah

\_\_\_\_\_ FT. FROM N. LINE

\_\_\_\_\_ FT. FROM S. LINE

\_\_\_\_\_ FT. FROM E. LINE

\_\_\_\_\_ FT. FROM W. LINE

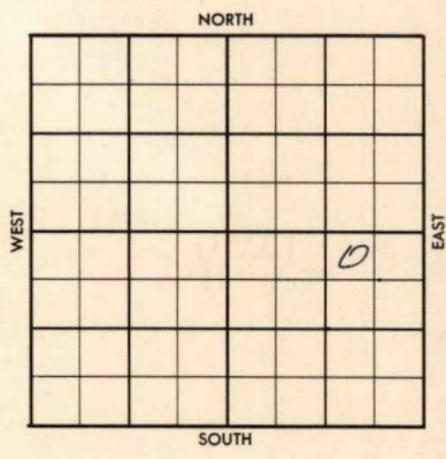

NW NE SE

1956	ELEVATION	REPORT
------	-----------	--------

8-29 Comm. 8-27-56  
10" @ 317 w/175  
Drlg. 320

County **Trego** Elev. \_\_\_\_\_  
 Sec. **27** Twp. **12S** Rge. **22W**  
 Company **The Texas Co. OGALLAH UNIT 1-11**  
 Farm Name **Geo. Bittel** No. **11**

TOPS	DEPTH	LOG	DATUM
Anh.			
Tp.			
H.			
Tr.			
Dg.			
Bl.			
L.			
K.C.			
B.K.C.			
Ce.			
C.			
M.			
M.			
K.			
Mz.			
Mq.			
V.			
S.			
S.			
A.			
R.			
PE.			
G.			
T.D.			

Loc. in Sec. **NW NE SE**  
 Geol. \_\_\_\_\_  
 Contr. \_\_\_\_\_  
**Stickle**  
 Pool **Ogallah**

FIRST REPORT  
 AUG 29 56

Date Comm. **8-27-56**  
**10" 317 w/175; D 320**

8221 2 938

R.G.

Co.  
 Lse.  
 No.  
 Sec.  
 T.  
 R.

County Trego Elev. 2360  
 Sec. 27 Twp. 12S Rge. 22W  
 Company The Texas Co. OGALLAH UNIT I-II  
 Farm Name Geo. Bittel No. 11

TOPS	DEPTH	LOG	DATUM	Loc. in Sec.
Anh.				NW NE SE
Tp.	3400			
H.	3595			
Tr.	3614			
Dg.				
Bl.				
L.	3627			Geol.
K.C.				Contr.
B.K.C.				Stickle
Ce.				Pool
C.				Ogallah
M.				<div style="border: 1px solid black; padding: 5px; text-align: center;">                     COMPLETE                      °                 </div>
M.				
K.				
Mz.				
Mo.				
V.				
S.				
S.				
A.	4040			
R.				
Pe.				
G.				
To.	4054			

Date Comm. 8-27-56 OCT 10 1956

10" 317 w/175; D 320 SEP 5 '56 DST  
 3404-34 thru 200' SW BHP  
 1080/20" D 3573 SEP 12 '56 cfd  
 4043-54 sec 11' 7" 4040  
 1175 WOC. SEP 19 '56 CO 4054 TST  
 3/8 B0 + 3/8 BWS 6 hrs. 1/2  
 \$ 29 B0 + 3 1/2 B acid wtr  
 11 hrs SEP 26 '56 \$ 11 B0 no/w 6 hrs  
 P. 12 B0 3 hrs P. 30 B0 8 hrs

OCT 3 '58

OCT 10 '58

Ph P. 90 Bopd

no/wt