



Trigo

KANSAS

Sec. 27 Twp. 12 R. 22 W

Well No. # 2 I. M. Turner Farm

Texas Company

Contractor

Ogallah W


Ft. from N. Line

330 Ft. from S. Line

990 Ft. from E. Line

Ft. from W. Line

SW SE NW

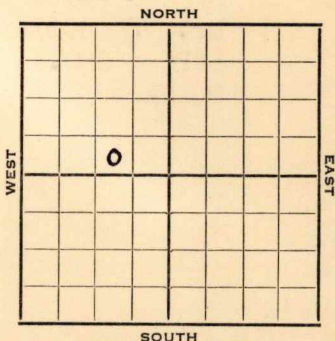

1952

Elev. 2370' REPORT

2/27

Spud 2-22-52  
8" @ 492'  
Drlg. 2350'

3/5

Drlg. 3972'

3/12

Topeka 3410' Heeb 3605' Lans 3640'  
Arb. 4053' RTD 4061' 5" @ 4054'  
WOCT

3/19

(Cor. TD 4059) DP CO to 4059  
S/1-7/10 gal wph DD to 4061  
S/VSSO&W DO to 4062 500 A CO

3/25

S/ 3 gal oph 300 A S/ 28 gal oil  
& 9 gal AW 1 hr. DD to 4073  
TD S/ 56 BO & 22 BW 6 hrs.  
PB 4072 WOC

4/1

S/ gal oil & 4 gal. wph 300 A  
S/ 1 bo & 8 BWPH for 3 hrs.  
sw/ off 4067-68

4/9

DP to TD DD 4076 test 5 gal oil &  
7 gal wtr. 3 hrs. DD 4081 s/down  
S/ 14 BO & 192 BW 14 hrs. PB 4067  
S/ dry to Hydra

4/23

S/12 BWPH plus SSO

4/30

Spud 2-22-52  
D & A TD 4081' 8" @ 492  
Top 3416' Heeb 3605' Lans. 3640'  
Arb. 4053' 5" @ 4054' TD 4059'

OVER

1952  
4/30

(Information continued)

S/1.7 GWPH DD 4061' S/VSSO & W  
DD 4062 500 A S/3 GOPH DD 4063  
S/7 GOPH 300 A S/28 GO 9 gal acid  
water. DD 4073 S/56 BO 22 BW 6 hr.  
PB 4073 ~~XXXXXXXXXX~~ S/5 GO 4 GWPH  
300 A S/1 BO 8 BWPH 3 hr. CO to  
4076 5 GO 7 GW 3 hr. DD 4081'  
S/down 300 A S/14 BO 192 BW 14  
hr. PB 4067' S/dry Hydro. S/12  
BWPH & SSO.  
D & A

**ABANDONED**

County **Trego** State **Kansas**

Sec. **27** (Blk.) **12** (Sur.) **22W** Map No.

Operator **Texas**

Well No. **2** Farm **I. M. Turner**

Elev. **2370** Location **SW SE NW**


**330** Ft. From **S** Line **NW**

**990** Ft. From **E** Line Quarter

1st. Report **FEB 27 1952**

Completion

Remarks

Spudding Date **2-22-52**

Drlg. Data **Ogallah W**

**8" @ 492 Drlg. 2350**

**J. G. McGEHEE**

