


Rice

KANSAS

SECTION 2 TOWNSHIP 18 RANGE 9 W

WELL NO. #1 Ogden

COMPANY Lotus Oil

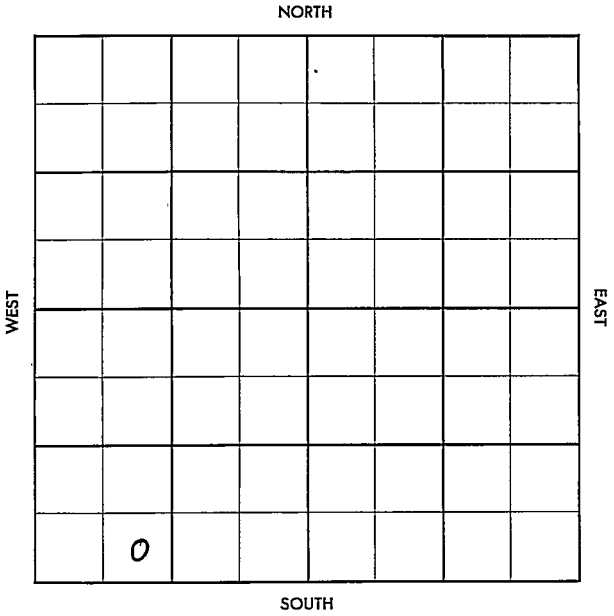

County Rice Elev. _____
 Sec. 2 Twp. 18 Rge. 9W
 Company Lotus Oil
 Farm Name Ogden No. 1

TOPS	DEPTH	LOG	DATUM
Anh.			
Tp.			
H.			
Tr.			
Dg.			
BL.			
L.			
K.C.			
B.K.C.			
Ce.			
C.			
M.			
M.			
K.			
Mz.			
Me.			
V.			
S.			
S.			
A.			
R.			
PE.			
G.			
T.D.			

Loc. in Sec.

SE SW SW

Geol.

Contr.

Lewis

Pool

Frederick

FIRST REPORT
 DEC 21 '55

Date Comm.

Location

Co.

Lse.

No.

Sec.

T.

R.

County Rice Elev. 1752
 Sec. 2 Twp. 18 Rge. 9W
 Company Lotus Oil
 Farm Name Ogden No. 1

TOPS	DEPTH	LOG	DATUM	Loc. in Sec.
Anh.				SE SW SW
Tr.				
H.	<u>27.51</u>			
Dg.				
BL.	<u>2876</u>			
L.	<u>2896</u>		<u>1144</u>	Geol.
K.C.				Contr.
B.K.C.				
Ce.				
C.	<u>3265</u>		<u>1513</u>	<u>Lewis</u>
M.				Pool
M.				<u>Frederick</u>
K.				
Mz.				
Ma.				
V.				
S.	<u>3269</u>		<u>1517</u>	
S.				
A.				
R.				
Pe.				
G.				
TD.	<u>3272</u>			

Date Comm. 12-21-55 JAN 1 8 1956

8 5/8" @ 200 DST 3086-95 open 1 hr.

rec. 240' SW 1120/20" 5 1/2" @ 3269/130

DD 3280 20 gw PB 3273 1000 A

S/ 1 1/4 boph 24 hr. PB 3268

6/ 3265-68 250 A wtr.

Temp. abd.