


Section 27 Township 12 Range 22 W

Well No. # 1 Tawney

Company Buffalo Oil

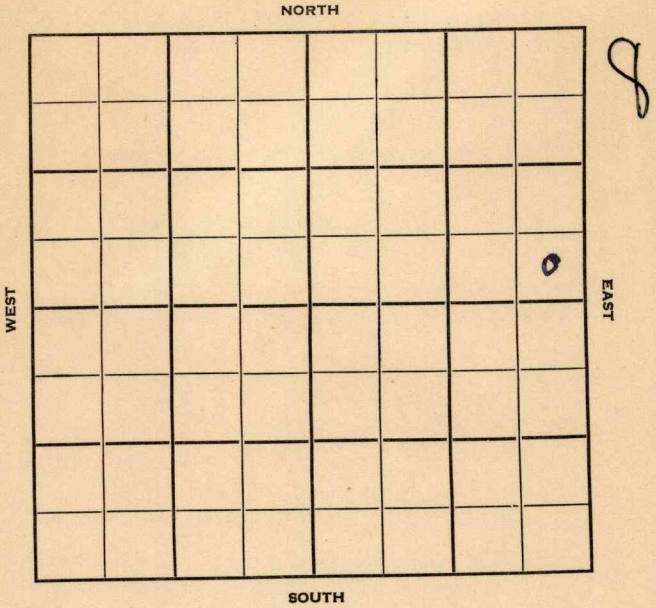



Sec. 27 Twp. 12 R. 22 W

Well No. # 1 Tawney Farm

Buffalo Oil Company

Contractor

Ft. from N. Line


330

Ft. from S. Line

330 Ft. from E. Line

Ft. from W. Line

SE SE NE

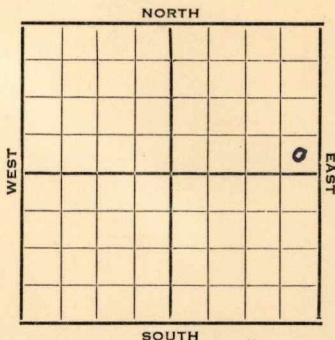

1952 Elev. 2376' REPORT

- 9/10 Location
- 9/17 "
- 9/24 "
- 10/1 8" @ 160'
- 10/8 Topeka 3381'
Drlg. 3405'
- 10/15 Lans 3644
DST 3407-27, 1 hr., rec. 4' M
- 10/22 DST 4048-52 1 hr., 6' VSOCM
DST 4050-57 1 hr., 27' VSOCM
DST 4051-62, 1 hr., 6' OCM 895#
Arb 4047'
RTD 4062 Schl
5" @ 4052'
- 10/29 CO 4062' DD 4066' TD S/1 BOPH
500 A S/5 BOPH POP
- 11/5 NR
- 11/12 "
- 11/20 "
- 11/27 "
- 12/3 Oil Well
TD 4066'
8" @ 160'

OVER

(Information Brought Forward)

1952
12/3

Top. 3390'

DST 3536-85, opn 1 hr., rec.
35' mud

Heeb 3612, Tor 3631, Lans 3644,

DST 3639-63, opn 1 hr., rec.
45' mud

DST 3660-92, opn 1 hr., rec.
875' sw

DST 4007-27, opn 1 hr., rec. 4'
mud

DST 4048-52, opn 1 hr., rec.
6' vsocm

DST 4050-57, opn 1 hr., rec.
27' vsocm

DST 4051-62, opn 1 hr., rec.
6' ocm, 895#

Arb. 4047

TD 4062

5" 4052 CO to 4062 SSO

DD 4066 S/1 boph 500A

S/5 boph

Comp. 77 bopd

COMPLETED

County Trego State Kansas

Sec. 27 (Blk. 12 (Sur. 22W Map No.)
(Twp.) (Rge.)

Operator Buffalo Oil

Well No. 1 Farm Tawney

Elev. 2376 Location SE SE NE

330 Ft. From S Line NE

330 Ft. From E Line Quarter

1st. Report

Completion DEC 3 1952

Remarks

Spudding Date

Drlg. Data Oil well TD 4066

8" @ 160 Top. 3390 DST 3536-85

open 1 hr. Rec. 35' mud Heeb. 3612

Tor. 3631 Lans. 3644 DST 3639-63

open 1 hr. Rec. 45' mud DST 3660-92

open 1 hr. Rec. 875' sw DST 4007-27

open 1 hr. Rec. 4' mud DST 4048-52

open 1 hr. Rec. 6' vsocm DST 4050-57

open 1 hr. Rec. 27' vsocm DST 4051-62

open 1 hr. Rec. 6' ocm 895# Arb. 4047

TD 4062 5" @ 4052 CO to 4062 SSO

DD 4066 S/ 1 boph 500 A S/ 5 boph

Comp. 77 bopd

