


Section 28 Township 12 Range 22W

Well No. #2 Anderson

Company Murfin Drlg. etal

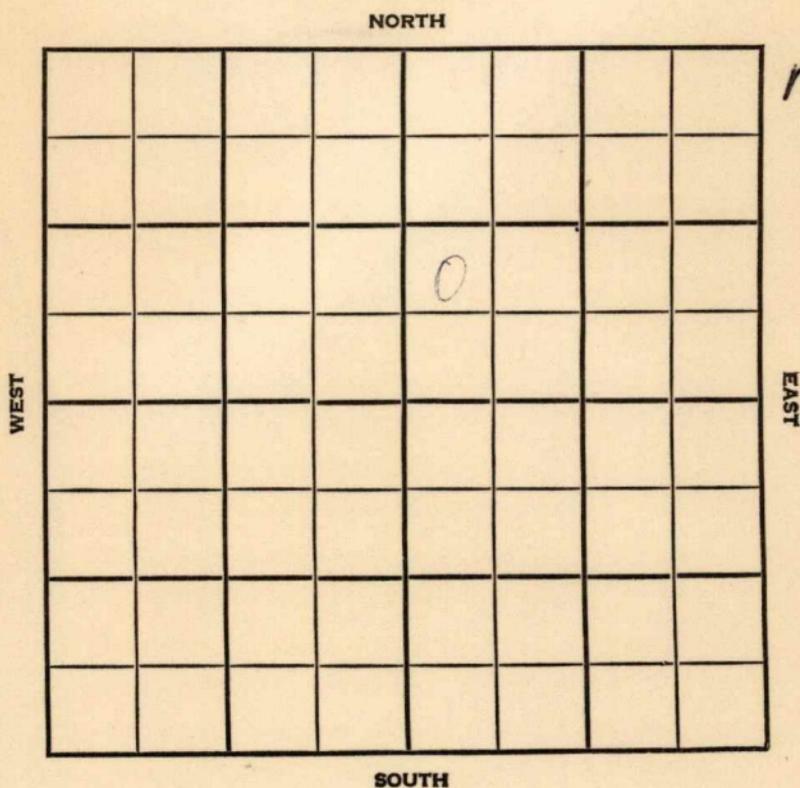

County Trego Elev. _____
 Sec. 28 Twp. 12 Rge. 22W
 Company Murfin Drlg. etal
 FarmName Anderson No. 2

TOPS	DEPTH	LOG	DATUM
Anh.			
TP.			
H.			
Tr.			
Dg.			
BL.			
L.			
K.C.			
B.K.C.			
Ce.			
C.			
M.			
M.			
K.			
Mz.			
Mo.			
V.			
S.			
S.			
A.			
R.			
PE.			
G.			
T.D.			

Loc. in Sec. NW SW NE
 Geol. _____
 Contr. _____
 Co. Tools _____
 Pool _____
 Ogalla



Date Comm. MIRT

NOV 5 1958

R. G.

Co.
Lse.
No.
Sec.
T.
R.

County Trego Elev. 2379
 Sec. 28 Twp. 12 Rge. 22W
 Company Murfin Drlg. etal
 Farm Name Anderson No. 2

	TOPS	DEPTH	LOG	DATUM
Anh.				
Tp.		3420		
H.		3614		
Tr.				
Dg.				
Bl.				
L.		3645		
K.C.				
B.K.C.		3887		
Ce.				
C.	Marm	3943		
M.	89	3962		
M.				
K.				
Mz.				
Me.				
V.				
S.		4014		
S.				
A.		4044		
R.				
PE.				
G.				
T.D.		4100		

Loc. in Sec. NW SW NE

Geol. _____
 Contr. _____
 Co. Tools _____
 Pool _____
 Ogalla



Date Comm.

MIRT OCT 31 '56 WORT NOV 7 '56 10-31-56

858 170/135 # 3225 NOV 13 '56

DST 3648-88 1hr 45' 50CSW BHP

1000/20 DST 4044-59 1hr new

7' Md BHP 0 NOV 21 '56 DST 4080-90

1hr 30' Md BHP 0

D&A

Co.
 No.
 Sec.
 T.
 R.