


Trego

KANSAS

SECTION 35 TOWNSHIP 12S RANGE 22W

WELL NO. #7 Hendrickson

COMPANY Tenn. Gas Trans. Co.

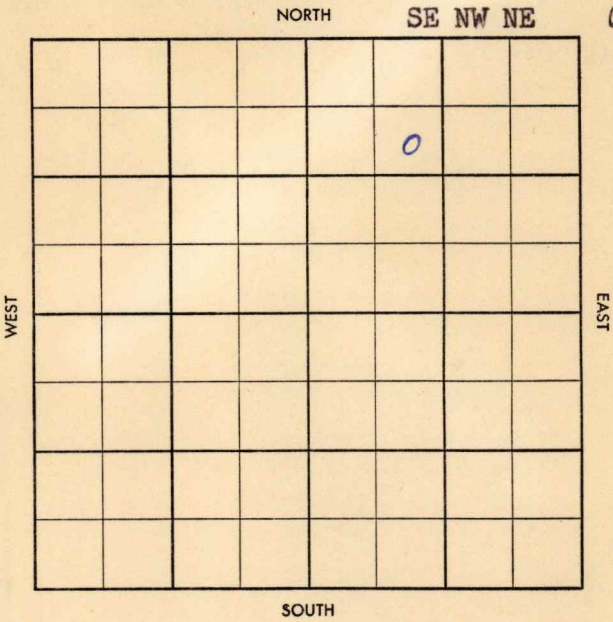

S-513-B

~~Top Pool~~
~~Co. Pool~~

County Trego Elev. 2298 DF 2301 RB
 Sec. 35 Twp. 12 Rge. 22W
 Company Tenn. Gas Trans. Co.
 Farm Name Hendrickson No. 7

TOPS	DEPTH	LOG	DATUM
Anh.			
Tp.	3332		
H.	3527		
Tr.			
Dg.			
B.L.			
L.	3560		
K.C.			
B.K.C.	3801		
Ce.			
C.	3886		
M.arm	3858		
M.			
K.			
Mz.			
Mq.			
V.			
S.	3929		
S.			
A.	3951		
R.			
Pf.			
G.			
T.D.	4014		

Loc. in Sec. SE 1/4 NE
 Geol. _____
 Contr. _____
 Pool _____

0
COMPLETE
 SEP 10 '58

Date Comm. 8-2-58
8" @ 211, DST 3632-49 1 hr 270' O&GC 1380'
gcsw, BHP 1289, MICT CO 3979, Perf 4/3967-
68, Perf 16/3963-67 Swb 33.2 BOPH/17 hrs,
Swb 6.9 BOPH/8 hr, 5" @ 4011 TD 4014. POP
AUG 27 '58 - SEP 3 '58 SEP 10 '58 POT 10/Bo
pd NW 36°
arb 3963-68

Co. No. Sec. T. R.