


Section 4 Township 18 Range 9W

Well No. 1 Ogden

Company Delta Prod.

Wildcat
NORTH

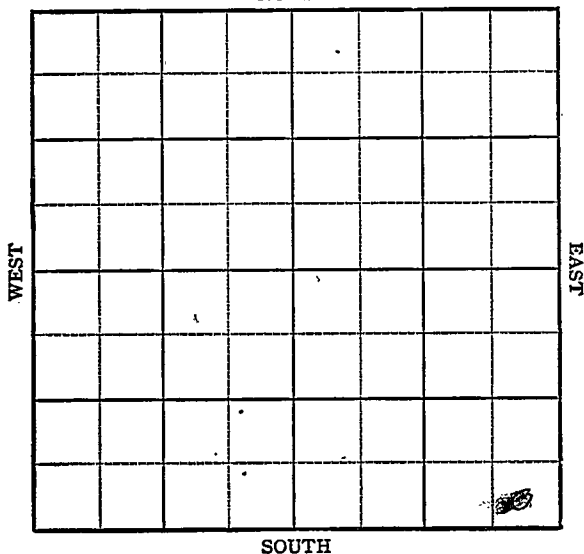

Sec. 4 Twp. 18 KANSAS R. 9W ✓

Well No. 1 Ogden Farm

Delta Prod. Company

Wildcat


 Ft. from N. Line

330 Ft. from S. Line

330 Ft. from E. Line

 Ft. from W. Line

SE/ C

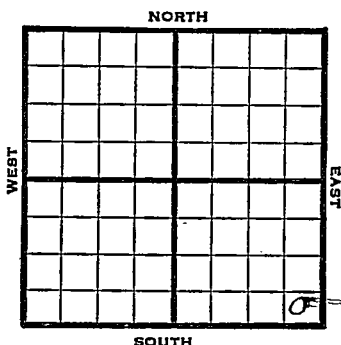

1948 Elev. 1740' REPORT

9/1 Location

9/8 8" @ 167'

Drlg 1958'

9/14 Lansing 2895'

Simpson Sand 3255'-62'

TD 3262'

5" @ 3256'

9/21 "

9/29 TD 3278'

Swb 1 1/4 bbls fluid PH 25% W

10/6 20 qts. 3271-78'

CO

10/13 Simp Sd 3255'

5" @ 3256'

Arb 3310'

TD 3311'

ABANDONED

Rice County Kansas State

Map No. _____ Sec. 4 Twp. 18 R. 9W

Well No. 1 Ogden

Delta Prod. Company

FIRST REPORT Contractor

SE/C

SECTION PLAT

Ft. from N. Line

330 Ft. from S. Line

330 Ft. from E. Line

_____ Ft. from W. Line



Wildcat

Remarks:

Location

Date SEP 1 1948

Scout **S. J. LEWIS**

Kansas

Wildcat

Map No. 45 Sec. 4 Twp. 18 R. 9WWell No. 1 Ogden

Delta Prod.

Company


ABANDONED

Contractor

SE/C

E11740

SECTION PLAT

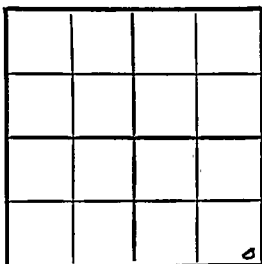 Ft. from N. Line330 Ft. from S. Line330 Ft. from E. Line Ft. from W. Line

Rice County

RECORD

Location Cased in. ft.Rig up Sand

Drilling and Remarks:

Gas Oil Total Depth 2311

PRODUCTION

1st 24 hrs. Nat. 1st 24 hrs. after shot Gas

Cu. Ft.

Dry Hole Abandoned

Date

OCT 13 1948 19

S. J. LEWIS

Scout