


Section 35 Township 12 Range 22 W

Well No. # 3 E. Hendrickson

Company Texas

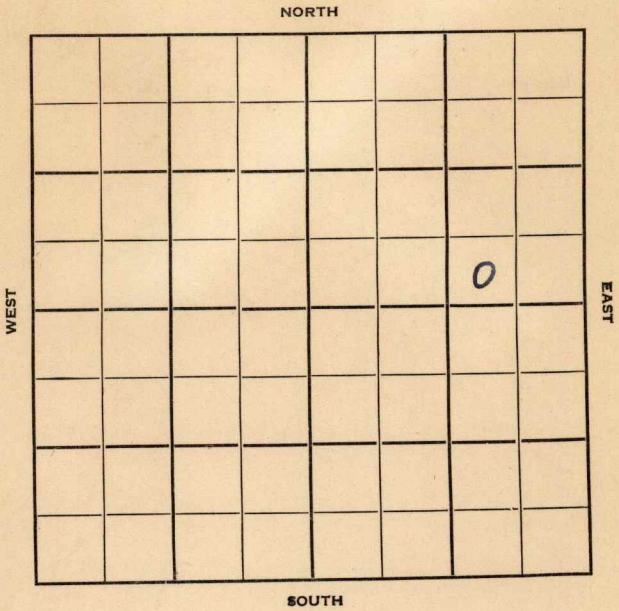

Trego

KANSAS ✓

Sec. 35 Twp. 12 R. 22W

Well No. #3 E. Hendrickson Farm

Texas Company

Noble - Contr. Contractor


Ft. from N. Line

330' Ft. from S. Line

990' Ft. from E. Line

Ft. from W. Line

SW SE NE

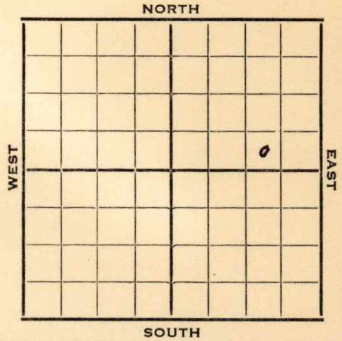

1952 Elev. 2294' REPORT

5/21 Spud 5-17-52  
10" @ 493  
Drlg. 1780'

5/28 Topeka 3349' Heeb 3544' Lans. 3578'  
Arb. 3955'  
DST 3958-82, 1 hr, 10' M 10#-15"  
Drlg. 3987'

6/11 TD 4235 7" @ 4010

6/18 Spud 5-17-52 SWD well  
TD 4235' 10" @ 493'  
Top. 3349 Heeb. 3544  
Lans. 3578 Arb. 3955  
DST 3958-82 open 1 hr. rec. 10' mud  
DST 3981-92 open 1 hr. rec. 1088' sw  
VSSO  
DST 4006-4234 open 1 hr. rec. 2700' sw  
Reagan 4233 TD 4235 7" @ 4010  
CO to 4235 Comp. for SWD well

**ABANDONED**

County **Trego** State **Kansas**

Sec. **35** (Blk. Twp.) **12** (Sur. Rge.) **22W** Map No.

Operator **Texas**

Well No. **3** Farm **E. Hendrickson**

Elev. Location **SW SE NE**


**FIRST REPORT**

**330** Ft. From **S** Line **NE**

**990** Ft. From **E** Line Quarter

1st. Report **MAY 21 1952**

Completion

Remarks **SWD**

**Noble - Contr.**

Spudding Date **5-17-52**

Drlg. Data

**10" @ 493 Drlg. 1780**

**J. G. McGEHEE**

County Trego State Kansas

Sec. 35 (Blk. 12 (Sur. 22W Map No.     )  
 (Twp.) (Rge.)

Operator Texas Company

Well No. 3 Farm E. Hendrickson

Elev. 2294 Location SW SE NE


330 Ft. From S Line NE

990 Ft. From E Line Quarter

Ist. Report     

Completion JUN 18 1952

Remarks     

Noble - Contr.

Spudding Date 5-17-52

Drlg. Data SWD well TD 4235

10" @ 493 Top. 3349 Heeb. 3544

Lans. 3578 Arb. 3955 DST 3958-82

open 1 hr. Rec. 10' mud DST 3981-92

open 1 hr. Rec. 1088' sw VSSO

DST 4006-4234 open 1 hr. Rec. 2700' sw

Reagan 4233 TD 4235 7" @ 4010

CO to 4235 Comp. for SWD well