

Trego

KANSAS

Section # 35 Township 12 Range 22W

Well No. #1 Hendrickson

Company Mid-States Oil

NORTH

WEST

EAST

							0

SOUTH

Trego

KANSAS



Sec. 35 Twp. 12 R. 22 W

Well No. # 1 Hendrickson Farm

Mid-States Oil Company

Harbar Drlg. Contractor


330 Ft. from N. Line

_____ Ft. from S. Line

330 Ft. from E. Line

_____ Ft. from W. Line

NE NE NE

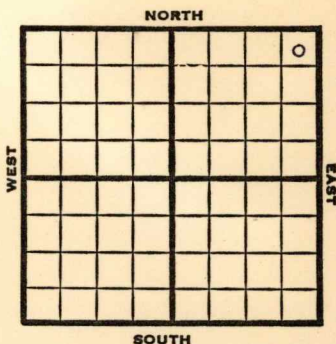

1951

Elev. 2310'

REPORT


5/9

Spud 5-8-51
Drlg.

6/13

Spud 5-8-51
Oil well TD 3999' 8" @ 200
Anhy 1740-55 Top 3338'
DST 3338-44 open 1 hr. rec 30' mud
DST 3338-49 open 1 hr. rec 40' mud & water
Heeb 3540' Lans 3571' B KC 3822'
Mar. 3881', Cong 3911'
DST 3902-16 open $\frac{1}{2}$ hr. rec 10' mud SSO
Miss chert 3920' Miss dol 3927'
Simp. 3945' Arb. 3979'
DST 3987-93 open $\frac{1}{2}$ hr. rec 1556' oil,
62' HOCM $5\frac{1}{2}$ " @ 3990 DC 3999'
FU 1000' oil 1 hr. 2100' 2 hr 2800'
3 hr. 3072' 4 hr. S/38 BOPH
Comp. draw down pot. 1506 BOPD

COMPLETED

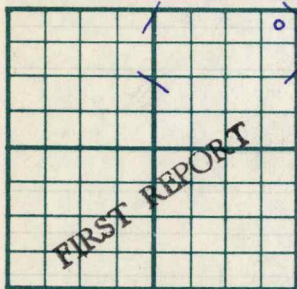County Trego State KansasSec. 35 (Blk. 12 (Sur. 22W Map No.Operator Mid-States OilWell No. 1 Farm HendricksonElev. Location NE NE NE330 Ft. From N Line NE330 Ft. From E Line Quarter1st. Report MAY 9 1951

Completion

Remarks

Harbar Drlg. - Contr.Spudding Date 5-8-51

Drlg. Data

drlg.

J. E. TYRA

Operator Mid-States Oil

Well No. 1 Farm Hendrickson

Elev.	2310	Location	NE NE NE
-------	------	----------	----------

A 10x10 grid with the word "COMPLETE" stamped diagonally across it. The stamp is in a bold, sans-serif font. There are also some small, dark marks or artifacts on the grid, particularly near the top right corner.

330 Ft. From N Line NE

330 Ft. From E Line Quarter

1st. Report

Completion JUN 13 1951

Remarks

Harbar Drlg. -Contr.

Spudding Date 5-8-51

Drig. Data Oil well TD 3999

8" @ 200 Anhy 1740-55 Top. 3338

DST 3338-44 open 1 hr. Rec. 30' mud

DST 3338-49 open 1 hr. Rec. 40' mud

& water Heeb. 3540 Lans. 3571

B KC 3822 Mar. 3881 Cong. 3911

DST 3902-16 open $\frac{1}{2}$ hr. Rec. 10'

mud SSO Miss. chert 3920

Miss. dol. 3927 Simp. 3945

Arb. 3979 DST 3987-93 open $\frac{1}{2}$ hr.

Rec. 1556' oil 62' hocm 5 $\frac{1}{2}$ " @ 3990

DC 3999 FU 1000' oil 1 hr.

2100' 2 hr. 2800' 3 hr.

3072' 4 hr. S/ 38 boph

Comp. draw down pot. 1506 bopd

J. E. TYRA