


Section 35 Township 12 Range 22W
Well No. #4 Hendrickson
Company Mid-States

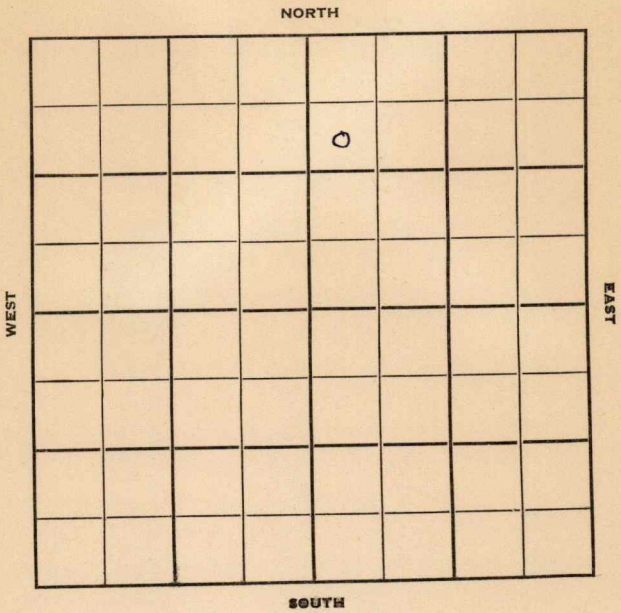

Trego

KANSAS

Sec. 35 Twp. 12 R. 22 W

Well No. # 4 Hendrickson Farm

Mid-States Company

Contractor

Ogallah Pool


990 Ft. from N. Line

_____ Ft. from S. Line

_____ Ft. from E. Line

330 Ft. from W. Line

SW NW NE

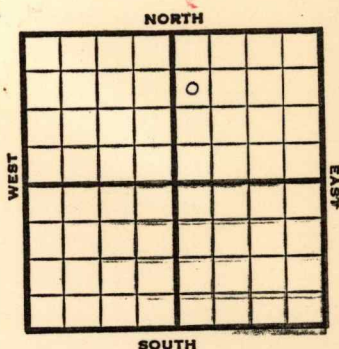

1951

Elev. 2322'

REPORT

8/15

Spud 8-8-51

9" @ 203

Drlg. 3220'

9/12

Spud 8-8-51

9" @ 203'

Lans. 3581'

Oil well

Top 3356'

TD 4000'

Heeb 3550'

DST 3609-24 open 1 hr. rec 40' OCM

DST 3623-38 open 1 hr. rec 65' OCM

70' SW.

Cong. 3912'

Simp. 3955'

Arb. 3972'

DST 3969-4000' open 1/2 hr. rec 2678' oil

300' OCM

5" @ 3973

TD 4000'

FU 3200' oil

1/2 hr.

S/60 BOPH

Comp. 3000 BOPD

COMPLETED

County **Trego** State **Kansas**Sec. **35** (Blk. Twp.) **12** (Sur. Rge.) **22W** Map No.Operator **Mid-States**Well No. **4** Farm **Hendrickson**Elev. Location **SW NW NE**

FIRST REPORT

990 Ft. From **N** Line **NE****330** Ft. From **W** Line **Quarter**1st. Report **AUG 15 1951**

Completion

Remarks

Spudding Date **8-8-51**Drlg. Data **Ogallah Pool****9" @ 203 drlg. 3220**

J. E. TYRA

J. E. TYRA