


Section 20 Township 33 Range 2-E

Well No. 1 Patton

Company ~~GREENLAND DRUG.~~
~~Phillips et al~~

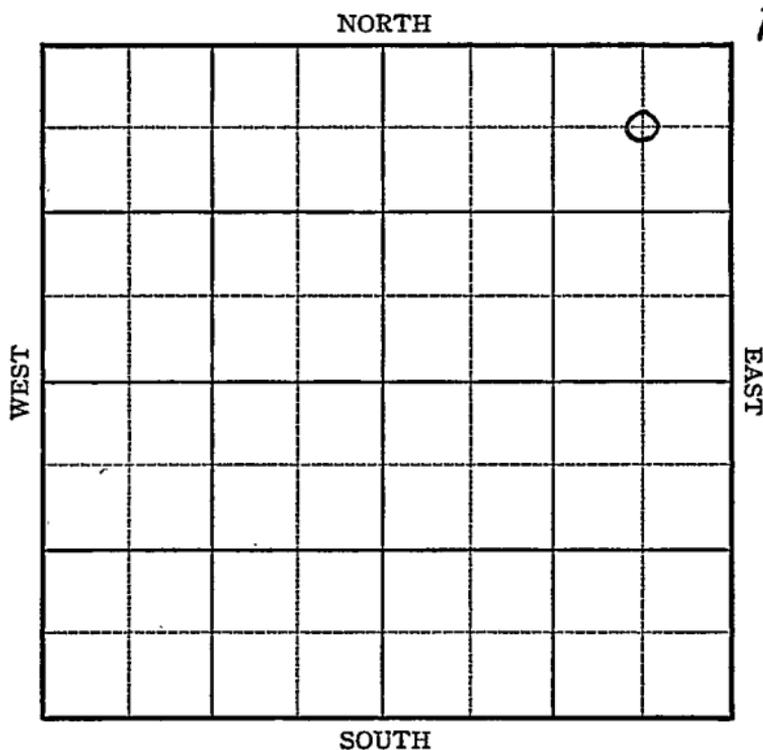

Sec. 20 Twp. 33 R. 2-E

Well No. #1 Patton Farm
GREENLAND DRUG.
Phillips et al Company

660 Ft. from N. Line


_____ Ft. from S. Line

660 Ft. from E. Line

_____ Ft. from W. Line

C N E N E

Elev. 1158

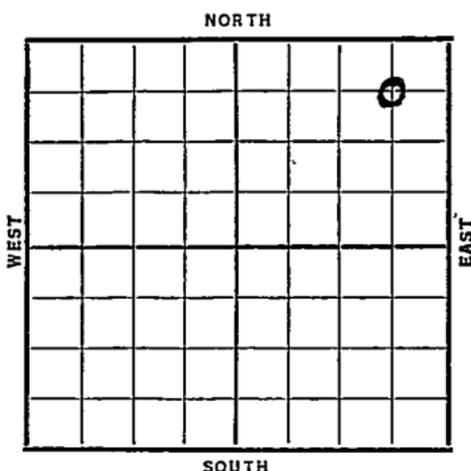

Date	REPORT
1937	
11/3	Location
11/12	12" @ 144'. WOC.
11/19	Drilg. 2700'.
11/26	Chat 3353'. S.O. 3360-70'.
	T.D. 3375' SD.
12/1	Cha t 3353'.
	T.D. 3375'.
	ABANDONED
1954	O.W.W.O.
4/7	Miss 3353'
	OTD 3375'
	To CO
4/21	D & A
	TD 3378'
	Miss 3353'
	OTD 3375'
	DD 3378'
	5" @ 3378'
	24/ 3304-10 2 bwp sd-frac wtr.
	D & A
	ABANDONED

Summer

KANSAS

Map No. / Sec. 20 Twp. 33 R. 2E

Well No. 1 Patton

Phillips etal Company

Contractor

FIRST REPORT

SECTION PLAT

660 **C NE NE**
Ft. from N. Line

_____ Ft. from S. Line

660 Ft. from E. Line

_____ Ft. from W. Line

			0

Location X

Rig up _____

Drilling and Remarks:

RECORD

Cased _____ in., _____ ft.

Sand _____

Gas _____

Oil _____

Total Depth _____

PRODUCTION

1st 24 hrs. Nat. _____

1st 24 hrs. after shot _____

Gas _____ Cu. Ft.

Dry Hole _____

Abandoned _____

Date

NOV 3 1937 19

H. D. Hatfield

Scout

O.W.W.O.


County Sumner State Kansas

Sec. 20 (Blk. 33 (Sur. Rge.) 2E Map No.

Operator Greenland Drlg. (was Phillips etal)

Well No. 1 Farm Patton

Elev. 1158 Location C NE NE

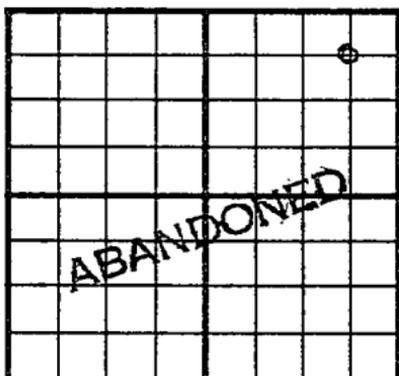

660 Ft. From N Line NE

660 Ft. From E Line Quarter

1st. Report

Completion APR 21 1954

Remarks O.W.W.O.

Spudding Date

Drlg. Data D & A TD 3378

Miss. 3353 OTD 3375 DD 3378 5" @ 3378

24/ 3304-10 2 bwph sd-frac wtr.

D & A

J. G. McGEHEE