

Sumner

KANSAS

SECTION 20 TOWNSHIP 33 RANGE 2 E

WELL NO. #1 Wright

COMPANY Shaver-Armour

NORTH

9

							6

WEST

EAST

SOUTH

SEC. 20	TWP. 33	R. 2E
------------	------------	----------

WELL NO. #1 Wright FARM

COMPANY Shawver-Armour

CONTRACTOR Co. Tools


Butter

_____ Ft. from N. Line

_____ Ft. from S. Line

_____ Ft. from E. Line

_____ Ft. from W. Line

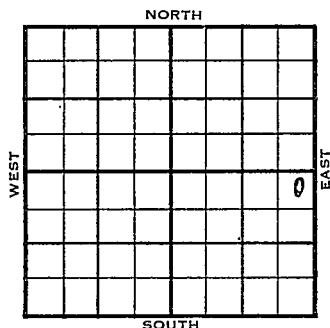

NE NE SE

1956	ELEVATION 1177'	REPORT
------	--------------------	--------

3-14 Comm. 3-11-56
8" @ 95/200
Drlg. 655

7-3 DST 3268-78 op 1 hr. rec. 153' mud,
DST 3301-15 op 2 hrs., rec. 15' mud,
50#.
5 1/2" @ 3553 w/50
CO 20/ 3300-16, frac, 1/2 bo, 5 bw,
~~###~~
PB 3290, 16/ 3268-72, 1/2 bo, 2 bw,
frac,
S/ 2 bo, 5 bw,
P/ 8 bo, 24 bw,
Comp. 5 bopd, 60 bw.
Stal. 2328', Layton 2728', KC. 2877',
Oswego 3064', Bart 3268', M. 3301',
S. Sd. 3474', A. 3552'.
TD 3608'.

COMPLETED

County Sumner Elev. 1177
 Sec. 20 Twp. 33 Rge. 2E
 Company Shawver - Armour
 FarmName Wright No. 1

TOPS	DEPTH	LOG	DATUM	Loc. in Sec.
Anh.				NE NE SE
Tr.				
Dg.				
Bl.				
L.				
K.C.	<u>2877</u>		<u>1700</u>	Geol.
B.K.C.	<u>3064</u>		<u>1887</u>	Contr.
Ce.	<u>3268</u>		<u>2091</u>	Co. tools
C.				Pool
M.	<u>3301</u>		<u>2124</u>	Butter
M.				
K.				
Mz.				
Mo.				
V.				
S.				
S.	<u>3474</u>		<u>2297</u>	COMPLETE
A	<u>3552</u>		<u>2375</u>	
R.				
PE.				
G.				
T.D.	<u>3608</u>			JUL 3 1956

Date Comm. 3-11-56
 8" @ 95/200 DST 3268-78 open 1 hr.
 rec. 153' mud DST 3301-15 open 2 hr.
 rec. 15' mud 50# 5 1/2" @ 3553/50
 CO 20/ 3300-16 frac 1/2 bo 5 bw
 PB 3290 16/ 3268-72 1/2 bo 2 bw
 frac S/ 2 bo 5 bw P/ 8 bo 24 bw
 Comp. 5 bopd 60 bw