


Sumner

KANSAS

SECTION 20 TOWNSHIP 33 RANGE 2E

WELL NO. #3 Wright

COMPANY Shawver & Armour

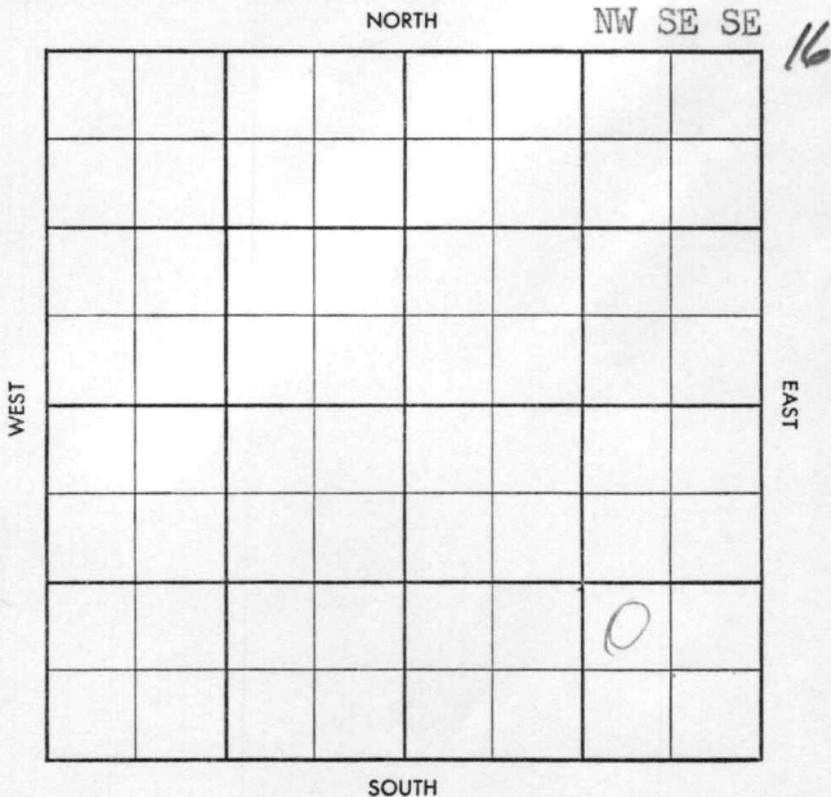

29

FORM 513 SUNRAY

County Sumner Elev. 1190
 Sec. 20 Twp. 33 Rge. 2E
 Company Shawver & Armour
 Farm Name Wright No. 3

Co.

TOPS	DEPTH	LOG	DATUM
Anh.			
Tr.			
H. <u>Stal.</u>	<u>2337</u>		
Tr.			
Dg.			
Bl.			
L.			
K.C.			
B.K.C.			
Ce.			
C.			
M.			
M.			
K.			
Mz.			
Ma.			
V.			
S.			
S.			
A.			
R.			
Pe.			
G.			
T.D.			

Loc. in Sec.

NW SE SE

Geol.

Contr.

Co. tools

Pool

Rutter



Lse.

No.

Sec.

T.

R.

Date Comm. 9-6-57
8" @ drlg. 2513

County Sumner Elev. 1190 DF
 Sec. 20 Twp. 33 Rge. 2E
 Company Shawver & Armour
 Farm Name Wright No. 3

TOPS	DEPTH	LOG	DATUM	Loc. in Sec.
Anh.				NW SE SE
Tr. <u>Stal.</u>	<u>2337</u>		<u>1146</u>	
Tr. <u>647</u>	<u>2531</u>		<u>1540</u>	
Dg.				
BL.				
L.				
K.C.	<u>2893</u>		<u>1692</u>	Geol.
B.K.C. <u>average</u>	<u>3069</u>		<u>1878</u>	Contr.
Ce. <u>Bart</u>	<u>3270</u>		<u>2079</u>	Co. tools
C.				Pool
M.	<u>3310</u>		<u>2117</u>	Rutter
M.				
K.				
Mz.				
Me.				
V.				
S.				
S.				
A.	<u>3545</u>		<u>3354</u>	COMPLETE
R.				
PE.				
G.				DEC 18 '57
T.D.	<u>3556</u>			

Date Comm. 9-6-57
 8" @ drlg. 2543 8 1/2 195
DST 3545 -56 SEP 25 '57 DST 3545
-56 1hr @ 30" @ 10 0 45"
FPO - 1221 BHP 1440 - 1410
5 1/2 3552/150 WOCT OCT 2 '57
CO 5 1/2 3552 OCT 9 '57 CO
3556 FU oil 30" DOP OCT 18 '57
 OCT 23 '57 OCT 30 '57 NOV 6 '57 NOV 13 '57 NOV 20 '57
DEC 4 '57 F1060DOPh NW DEC 11 '57
25BOPh NW arbutle