


Section 36 Township 12 Range 22W

Well No. 9 Kellogg - Wynn

Company Texas Company

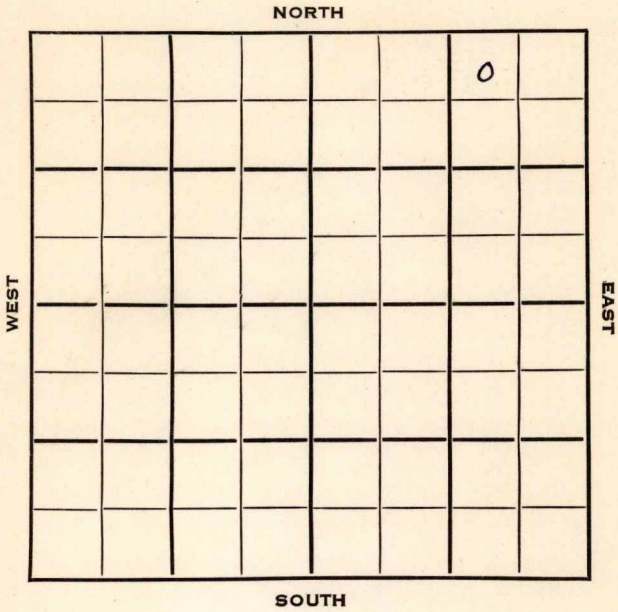

Trego

KANSAS ✓

Sec. 36 Twp. 12 R. 22W

Well No. #9 Kellogg-Wynn Farm

Texas Company Company

Bwell Drlg. Contractor


330 Ft. from N. Line

_____ Ft. from S. Line

990 Ft. from E. Line

_____ Ft. from W. Line

NW NE NE

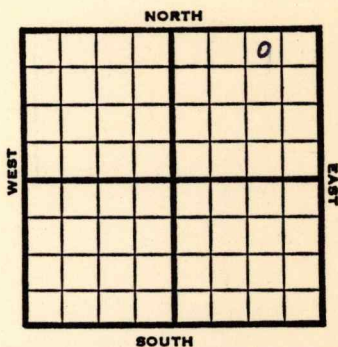

1953

Elev. 2304

REPORT

1/14

Location

1/22

10" @ 239
Drlg. 2260'

1/29

Top 3360, Heeb 3560, Lans 3594
Drlg. 3935'

2/5

Arb. 3977' TD 3991' 7" @ 3986 CO

2/12

CO 3991' 7 GOPH 500 A S/1 BFPH
35% wtr. DD 4003' TD 1 1/4 BO
plus 1/4 BWPH

2/18

Spudding Date 1/17/53
Oil Well TD 4003
10" @ 239 **Top 3360 Heeb. 3560**
Lans. 3594 Arb. 3977 TD 3991
7" @ 3986 CO to 3991 7 goph
500 A S/1 bfpH 35% wtr. DD 4003
1 1/4 bo 1/2 bw
Comp. 49 bopd
5 1/2 bw

COMPLETED

