


Section 35 Township 12 Range 22W

Well No. #3 U. S. Gov't

Company Central Cpmmerical Co.

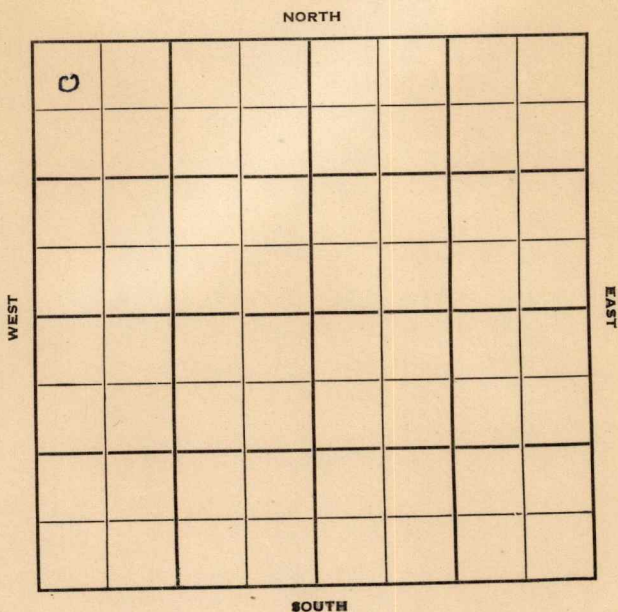

Sec. 35 Twp. 12 R. 22 W

Well No. # 3 U. S. Gov't. Farm

Central Commercial Co. Company

Peel Bros. Contractor


330 Ft. from N. Line

Ft. from S. Line

Ft. from E. Line

330 Ft. from W. Line

NW NW NW

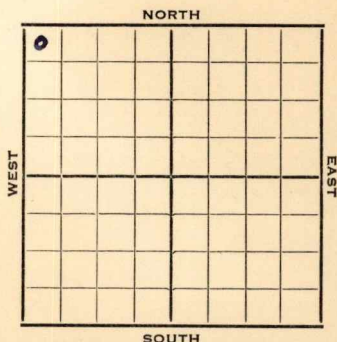

1952

Elev. 2342'

REPORT

9/24

Spud 9-17-52
8" @ 250 **Anhy 1770'**
Drlg. 2700'

10/1

DST in Topeka 3083-92 1/4 hrs.,
10' M
Heeb 3577, Lans 3610
Drlg. 3670'

10/8

Arb 4005
DST 4011-35, 1/2 hr., 3100' oil
& 250 gas
TD 4035
Run 5"

10/15

5" @ 4034'
CO to 4035' 93/4002-31
S/41 BOPH 6 hrs.

10/22

Spud 9-17-52
Oil Well
TD 4035
8" @ 250
Anhy 1770'
DST 3083-92, opn 1/4 hr., rec. 10' mud,
Heeb. 3577', Lans. 3610', Arb 4005'
DST 4011-35, opn 1/2 hr., rec. 3100'
oil 250' gas
TD 4035'

OVER

(Information Brought Forward)

1952

10/22

5" @ 4034

CO to 4035, 93/4002-31, FU 3105' oil

S/41 boph

Comp. 3000 bopd

COMPLETED

County Trego State Kansas

Sec. 35 (Blk. 12 (Sur. 22W (Twp.) (Rge.) Map No.

Operator Central Commercial Co.

Well No. 3 Farm U. S. Gov't

Elev. 2342 Location NW NW NW

0					

FIRST REPORT

330 Ft. From N Line NW

330 Ft. From W Line Quarter

1st. Report SEP 24 1952

Completion _____

Remarks _____

Peel Bros. - Contr.

Spudding Date 9-17-52

Drlg. Data _____

8" @ 250 Anhy 1770 drlg. 2700

County Trego State Kansas
 Sec. 35 (Blk. 12 (Sur. 22W Map No. (Twp.) (Rge.))
 Operator Central Commerical Co.
 Well No. 3 Farm U. S. Gov't
 Elev. 2342 Location NW NW NW

0					

COMPLETE

330 Ft. From N Line NW
330 Ft. From W Line Quarter
 Ist. Report
 Completion OCT 22 1952
 Remarks
Peel Bros. - Contr.
 Spudding Date 9-17-52

Drlg. Data Oil well TD 4035
8" @ 250 Anhy 1770 DST 3083-92
open $\frac{1}{4}$ hr. Rec. 10' mud Heeb. 3577
Lans. 3610 Arb. 4005 DST 4011-35
open $\frac{1}{2}$ hr. Rec. 3100' oil 250' gas
TD 4035 5" @ 4034 CO to 4035
93/ 4002-31 FU 3105' oil S/ 41 boph
Comp. 3000 bopd

Stamp: 2001 OCT 22 1952
Land Well No.
TREGO
2342
35
12
22W
12